

E2017

George
E 2017
3-26-81

MISSISSIPPI
BOARD OF WATER COMMISSIONERS
416 North State Street
Jackson, Mississippi 39201

WATER WELL DRILLERS LOG


3/26 date well completed 81 Cecil S. Howell firm name George county well located

LANDOWNER: <u>Bobby Dixon</u> <u>Ray Miss</u> (mailing address)	description of formations encountered <u>Silt</u> <u>Red clay</u> <u>Sand</u>	from	to
		<u>0</u>	<u>2</u>
		<u>2</u>	<u>15</u>
		<u>15</u>	<u>25</u>

WELL LOCATION:
sec 28 T 2 N R 8 E
6 miles N of Bumala
(distance) (direction) (nearest town)

WELL PURPOSE: Home
(home, irrigation, municipal, industrial)

- WELL COMPLETION DATA:
- (1) diameter (inches) 2"
 - (2) total depth (feet) 25
 - (3) static water level (feet) 19 below top of ground
 - (4) casing Plastic 25
(material) (depth)
(size) if telescope see back.
 - (5) screen 5 ft 20
(length) (depth to top)
2" Plastic
(size) (material)
 - (6) pump Electric 6
(type power) (HP) (yield/gpm)
 - (7) electric log
(yes or no)

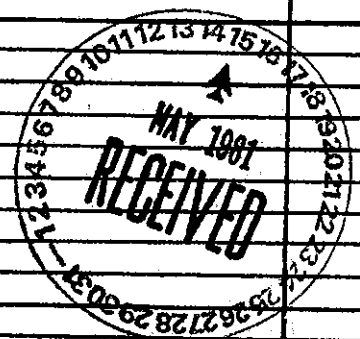

(organization running log)
(8) how well bottom plugged Back
wash valve

DRILLERS REMARKS: