

E2018

George
E 2018
3-28-81

MISSISSIPPI
BOARD OF WATER COMMISSIONERS
416 North State Street
Jackson, Mississippi 39201

WATER WELL DRILLERS LOG

3, 28, 81 81 Cecil S. Howells George
date well completed 1981 Water well Service county well located


LANDOWNER: St Register
Leaf Miss
(mailing address)

description of formations encountered	from	to
Dirt	0	2
Red dirt	2	11
Red Clay	11	21
Dark Sand	21	35
Blue Clay	35	333
Blue Clay	235	247
Blue Clay	247	302
Dark Sand	302	319
Sand + Gravel	319	333

WELL LOCATION:
sec 17 T 2 N R 8 E
8 miles S of Bennedale

WELL PURPOSE: Office Building
(home, irrigation, municipal, industrial)

- WELL COMPLETION DATA:
- (1) diameter (inches) 2"
 - (2) total depth (feet) 333
 - (3) static water level (feet) 106 below top of ground
 - (4) casing (material) Plastic (depth) 333 (size) If telescope see back.
 - (5) screen (length) 5 ft (depth to top) 328 (size) 2" (material) Plastic
 - (6) pump (HP) 2 (yield gpm) 6 Electric (type power)
 - (7) electric log (yes or no)
 - (8) how well bottom plugged Back Wash Valve

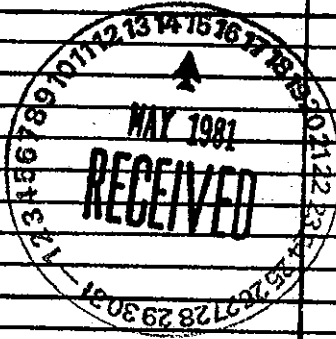

DRILLERS REMARKS: