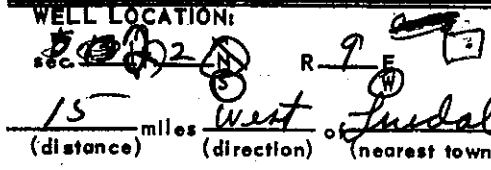


GEORGE
E 2045

MISSISSIPPI DEPARTMENT OF NATURAL RESOURCES
Bureau of Land and Water Resources
Southport Mall
P.O. Box 10631
Jackson, Mississippi 39209
WATER WELL DRILLERS LOG

9-6-86 19 Fiftyfogle Well Serv. George
date well completed firm name county well located

LANDOWNER: <u>ISSAC FAILEY'S</u> <u>MOTHER</u>	description of formations encountered	from	to
<u>LUCEDALE, MS</u> (mailing address)			
WELL LOCATION:  <u>15</u> miles <u>west</u> of <u>Lucedale</u> (distance) (direction) (nearest town)	<u>top soil</u>	<u>0</u>	<u>10</u>
WELL PURPOSE: <u>Home</u> (home, irrigation, municipal, industrial)	<u>top clay</u>	<u>10</u>	<u>20</u>
WELL COMPLETION DATA: (1) diameter (inches) <u>2"</u>	<u>fine sand</u>	<u>20</u>	<u>30</u>
(2) total depth (feet) <u>226</u>	<u>brown clay</u>	<u>30</u>	<u>50</u>
(3) static water level (feet) _____ below/above top of ground.	<u>blue clay</u>	<u>80</u>	<u>200</u>
(4) casing <u>PVC</u> , <u>216</u> , (material) (depth) <u>no</u> if telescope see back. (size)	<u>med sand</u>	<u>200</u>	<u>226</u>
(5) screen <u>10'</u> , <u>#6-216'</u> (length) (depth to top) <u>2'</u> , <u>PVC</u> (size) (material)			
(6) pump <u>HHP</u> , <u>4 HPM</u> (HP) (yield gpm) <u>Elect</u> (type power)			
(7) electric log <u>no</u> (yes or no) <u>no</u> (organization running log)			
(8) how well bottom plugged, <u>PVC</u> <u>Ball Check</u>			
DRILLERS REMARKS:			

RECEIVED

FEB 27 1987

Department of Natural Resources
Bureau of Land & Water Resources