

MISSISSIPPI
BOARD OF WATER COMMISSIONERS
416 North State Street
Jackson, Mississippi 39201

WATER WELL DRILLERS LOG **CODED**

George
F95
8/29/74

8/29 date well completed 1974 Pease Drilling Co. firm name George county well located

LANDOWNER: <u>Roy Myrick</u>	description of formations encountered	from	to
<u>Rt. 3</u>			
<u>Sucedale Mini</u> (mailing address)	<u>sand & clay</u>	<u>10</u>	<u>20</u>
	<u>sand</u>	<u>20</u>	<u>30</u>
	<u>clay</u>	<u>30</u>	<u>35</u>
	<u>shelled sand</u>	<u>35</u>	<u>50</u>

WELL LOCATION:
sec. 16 T. 20 N. R. 7 E.
10 miles west of Sucedale
(distance) (direction) (nearest town)

WELL PURPOSE:
 (home, irrigation, municipal, industrial)

WELL COMPLETION DATA:

(1) diameter (inches) 2"

(2) total depth (feet) 50'

(3) static water level (feet) 30 ^{below} above top of ground.

(4) casing PLASTIC 40
(material) (depth)

0 (size) if telescope see back.

(5) screen 10' 40'
(length) (depth to top)

0010 PLASTIC
(size) (material)

(6) pump 1 5
(HP) (yield gpm)


Elec
(type power)

(7) electric log (yes or no)

(organization running log)

(8) how well bottom plugged B.W.

CODED

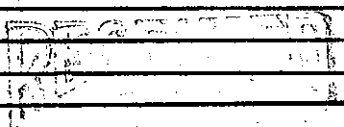

SEP 12 1974

DRILLERS REMARKS:

MISS. BD. OF WATER COMM