

State Well Report

Part I

Mississippi Department of Environmental Quality
Office of Land and Water Resources
P.O. Box 10631
Jackson, MS 39289-0631
(601)961-5210
(601)354-6938 (fax)

For Office Use Only:

Aquifer: _____
Well #: F-130
L. S. Elevation: _____
B-log #: _____

County: George
Permit #: _____
Driller: Mike
Date drilling completed: 2-24-06

State Law requires that this report be prepared by the driller in detail and filed with the Department within 30 days of completion of drilling of the well.

Well Owner Information	Well Location
Owner Name: <u>David Druey</u>	Latitude: <u>30° 48' 674M</u> Longitude: <u>088° 38' 869W</u>
Mailing Address: <u>151 Park Lake Circle</u>	Method of Lat/Long (circle one): <u>Conventional Survey</u>
<u>Lucedale Ms 39452</u>	USGS quad, <u>Hand-held GPS</u> Survey-grade GPS
City State Zip Code	<u>NW 1/4 SW 1/4 Sec 36 Twn 72S Rng R7W</u>
Telephone No. () _____	Distance Direction Nearest Town
	<u>5 Miles SW of Lucedale</u>

Well Data

Purpose of Well (circle one) Home Industrial Public Supply Irrigation Fish Culture Other: _____

Date well drilling started: 2-24-06 Date well drilling completed: 2-24-06

If flowing, method of flow regulation: Valve _____ Other (describe) _____

Static Water Level: 43 feet above or below (circle one) land surface Date measured: _____

Method of Measurement (circle one) steel tape electric tape air line other: _____

Hole depth: 140 Well depth: 140 Well grouted to a depth of 10 feet

Type of grout (circle one): Cement Bentonite Mix

Casing length: 130 feet Casing diameter: 2 inches Type of casing: PVC 40

Screen length: 10 feet Screen diameter: 2 inches Type of screen: PVC wrapped

Screen slot size: 8 inches Setting depth: From 130 feet to 140 feet

Type of completion (circle all applicable): Gravel packed Underreamed Telescoped Open hole Natural Development

Other (describe): _____

Top of log pipe or reduction in casing: _____ feet. If telescoped or more than one screen, describe on back of page

Logs run (circle all applicable): No log run Electric Gamma Ray Density Sonic Neutron Other: _____

Name of organization running log(s): _____

I certify that the well was drilled, constructed, and completed in accordance with all applicable requirements of the Mississippi Department of Environmental Quality and/or the Mississippi Department of Health regulations and state laws.

Michael R Frye 01408

Print Name of Water Well Contractor and License No.

Michael R Frye 01408

Signature of Water Well Contractor

RECEIVED

MAR 28 2006

BY: OLWR

R-130


If well telescopes please sketch below and show depths.

Ground Level _____

Description of Formations Encountered	From	To
sand	0	6
Clay	6	8
sand	8	30
Clay	30	31
sand	31	38
Clay	38	39
sand	39	58
Blue Clay	58	85
fine gravel silt	85	125
laminated sand	125	140

If more than one screen, show location of each on sketch

Sketch the property layout and include the following: 1) the well location; 2) any permanent structures on the property that may aid in locating the well; 3) any roads, power lines, or other items that may aid in locating the property and the well; 4) indicate direction.

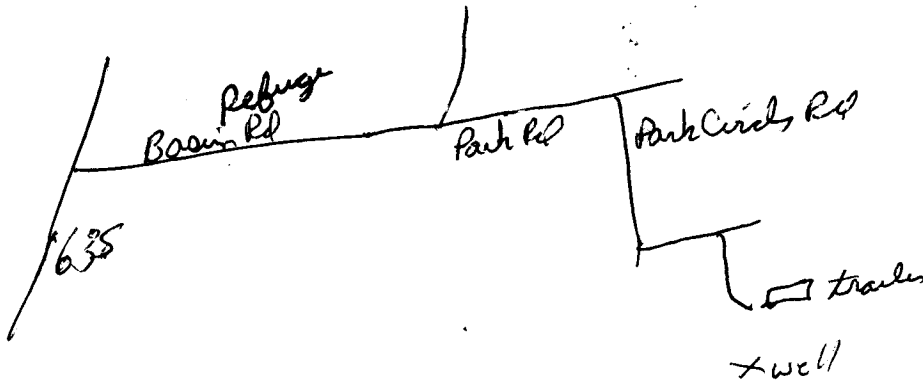

Landowner Name: David Oruey

Michael R. Trapp 0408
 Signature of Water Well Contractor

RECEIVED
 MAR 28 2006
 BY: OLWR

STATE WELL REPORT

Part 2

Pump Installer's Completion Report
Mississippi Department of Environmental Quality
Office of Land and Water Resources
P.O. Box 10631
Jackson, MS 39289-0631
(601)961-5210
(601)354-6938 (fax)

For Office Use Only:

Aquifer: _____

Well #: F-130

Elevation: _____

County: DeWitt
Permit #: _____
Driller: Mick
Date completed: 3-6-06

This report should be prepared by the pump installer in detail and filed with the Department within 30 days of the installation of pump.

Well Owner Information	Well Location
Owner Name: <u>David Druey</u>	Latitude: <u>30-48-674N</u> Longitude: <u>088-38-869W</u>
Mailing Address: <u>151 Parkside Circle</u>	Method of Lat/Long (circle one): <u>Conventional Survey</u>
<u>Lucedale MS 39452</u>	USGS quad, <u>Hand-held GPS</u> , Survey-grade GPS
City State Zip Code	<u>1/4</u> <u>1/4</u> Sec. <u>36</u> Twp. <u>T25</u> Rng. <u>R7W</u>
Telephone No. () _____	Distance Direction Nearest Town
	<u>5</u> Miles <u>SW</u> of <u>Lucedale</u>

Pump Type Circle one	Power Type Circle one
Air Lift <input checked="" type="radio"/> Jet <input type="radio"/> Submersible	Diesel Engine Gasoline Engine Natural Gas
Bucket <input type="radio"/> Piston <input type="radio"/> Turbine	<input checked="" type="radio"/> Electric Motor <input type="radio"/> Hand <input type="radio"/> Tractor PTO
Centrifugal <input type="radio"/> Rotary <input type="radio"/> Flowing Well	Windmill Other (specify): _____
Other (specify): _____	Horse Power Rating of Motor: <u>1</u>
Date Pump Installed: <u>3-6-06</u>	Setting Depth: <u>60</u> feet
Rated Pump Capacity: <u>8-12</u> Gallons Per Minute	Number of Stages: <u>2</u>

Pump Test Data	Method of Measuring Water Level Circle one
Date Well Tested: _____	<input checked="" type="radio"/> Air Line <input type="radio"/> Electric Measuring Line <input type="radio"/> Steel Tape
Static Water Level (A): <u>43</u> Feet Below Land Surface	Other (specify): _____
Pumping Water Level (B): <u>53</u> Feet Below Land Surface	For flowing well, measured shut in head: _____ feet
Drawdown ((B) - (A)): <u>10</u> Feet Below Land Surface	Well yielded <u>8</u> GPM with a drawdown of
Test Pumping Rate: <u>8</u> Gallons Per Minute	<u>10</u> feet after <u>1 1/2</u> hours of pumping
Duration of Pump Test (minimum 4 hours): <u>4</u> hours	

I HEREBY CERTIFY that the above statements are true to the best of my knowledge.

Michael R Fry Fogle 0408
Print Name of Pump Installer and License No. (if applicable)

Michael R Fry Fogle 0408
Signature of Pump Installer

RECEIVED

MAR 28 2006

BY: OLWR