STATE WELL REPORT						
County: George Permit #:	D Mississippi Depart Office of La Jacks ((60 <i>be prepared by the</i> <i>ithin 30 days of co</i> ion a water well)	Part 1 priller's Log ment of Environmental Quality and and Water Resources P.O. Box 2309 on, MS 39225-2309 601)961-5555 1)961-5228 (fax) license holder responsible for the mpletion of drilling of the well of	he work and filed with or borehole. hole Location ngitude: <u>-88.6411</u>	RECEIVED 10-05-2021 the BY OLWR 860		
Mailing Address: TOO LIZZIO TI Lucedale Ms City State Telephone No. ()	39452 Zip Code	USGS quad, Hand-held G <u>NE</u> 1/4 <u>NW</u> 1/4, Sec <u>4.40</u> Miles <u>SW</u> 0 (Distance) (Direction)	13 _T 2S _R	<u>7W</u>		
	drilling completed: vater used for drillin ne used in drilling a un교Electric Gam Well 교 Geotechn ic Survey Other	ng: None nd development: na Ray Density Sonic Neutro	on Other: Ground Source Heat Pur	mp		
Purpose of Well (check all applicable): Other (describe): If a flowing well, method of flow regul Static Water Level: <u>28</u> feet Method of measurement (check one): Well depth: <u>70</u> Well grouted to a Casing length: <u>60</u> feet Ca Screen length: <u>10</u> feet S Screen slot size: <u>.08</u> inches Type of completion (check all applicabl Other (describe): Top of lap pipe or reduction in casing:	ation: Valve [above or [] belo (check one) Steel tape Electric depth of: <u>10</u> f asing diameter: <u>4</u> creen diameter: <u>4</u> Setting depth: e): Gravel packed[]	Other (describe) ow] land surface Date measur tape Air line Other (describe) teet Type of grout (check one): inches Type of content inches Type of content	ed: 09/26/202 Neat Cement Bentor Sasing: Sch40 Screen: Wrap 070 fe Natural Development	1 nite Mix		
If telescoped or more than one screen, describe on next page						

County:	George	
,		
Permit #:		

If well telescopes, show depths on sketch.

×

Ground Level



For Office Use Only:

Well #: _____F175

The sketch below only required for water wells


Description of formations encountered must be provided for all wells and boreholes, unless specifically exempted by regulations

Description of Formations Encountered	From (depth)	To (depth)
Mix	Ground level	18
Clay	18	27
Sand	27	32
Clay mix	32	38
Sand	38	70

If more than one screen, show location of each on sketch

Sketch the property layout and include the following:

- 1) the well location
- 2) any permanent structures on the property that may aid in locating the well
- 3) any roads, power lines, or other items that may aid in locating the property and the well
- 4) north arrow

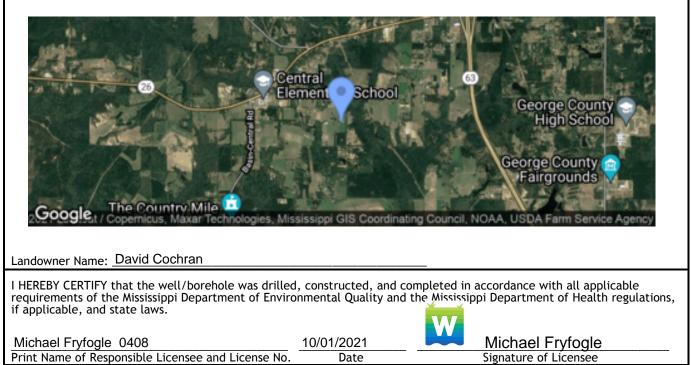

Form: OLWR-SWR-1B (4/13)