

STATE WELL REPORT

Part 1

Driller's Log

Mississippi Department of Environmental Quality
Office of Land and Water Resources
P.O. Box 2309
Jackson, MS 39225-2309
(601)961-5555
(601)961-5228 (fax)

192



For Office Use Only:

Well #:
Aquifer: F177
E-Log #:

County: George
Permit #:
Driller: Michael Fryfogle
Date drilling completed: 09/26/2021

State Law requires that this report be prepared by the license holder responsible for the work and filed with the Department at the above address within 30 days of completion of drilling of the well or borehole.

Well Owner Information and Well or Borehole Location section containing owner name (David Cochran), address (160 Lizzie Holland Rd), and location details (Latitude: 30.8774250, Longitude: -88.6411860).

Well / Borehole Data section containing drilling dates (09/26/2021), hole depth (70), diameter (7 1/4), and purpose of borehole (Water Well).


Purpose of Well and measurement details section containing well depth (70), casing length (60), screen length (10), and completion type (Gravel packed).

RECEIVED
 BY OLWR

County: George
 Permit #: _____

For Office Use Only: 10-11-2021
 Well #: _____

The sketch below only required for water wells
If well telescopes, show depths on sketch.

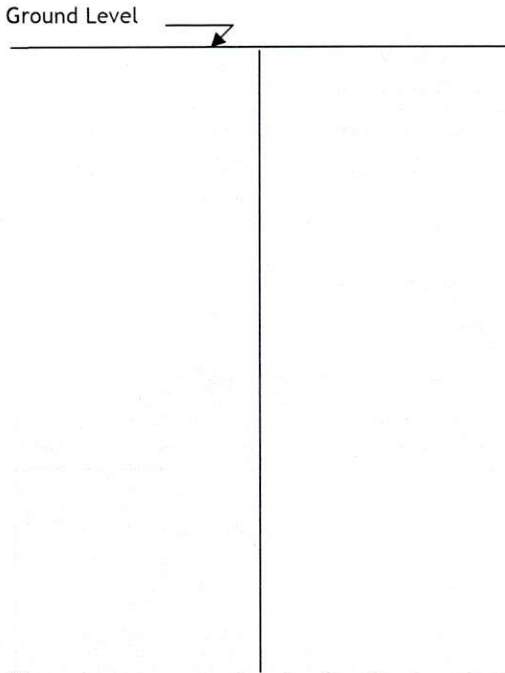


Description of formations encountered must be provided for all wells and boreholes, unless specifically exempted by regulations

Description of Formations Encountered	From (depth)	To (depth)
Mix	Ground level	18
Clay	18	27
Sand	27	32
Clay mix	32	38
Sand	38	70

If more than one screen, show location of each on sketch


Sketch the property layout and include the following:

- 1) the well location
- 2) any permanent structures on the property that may aid in locating the well
- 3) any roads, power lines, or other items that may aid in locating the property and the well
- 4) north arrow

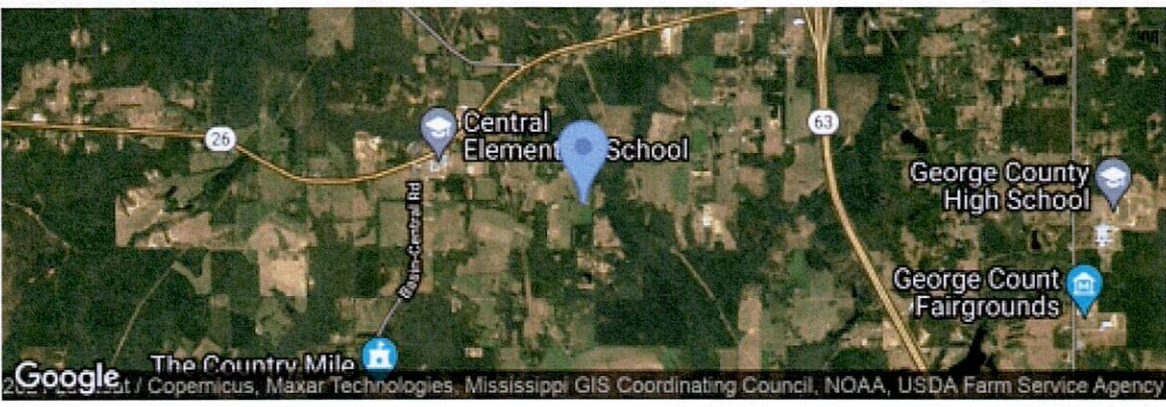

Landowner Name: David Cochran

I HEREBY CERTIFY that the well/borehole was drilled, constructed, and completed in accordance with all applicable requirements of the Mississippi Department of Environmental Quality and the Mississippi Department of Health regulations, if applicable, and state laws.

Michael Fryfogle 0408 09/27/2021  Michael Fryfogle
 Print Name of Responsible Licensee and License No. Date Signature of Licensee