

George
F 2832
4-25-81

MISSISSIPPI
BOARD OF WATER COMMISSIONERS
416 North State Street
Jackson, Mississippi 39201

WATER WELL DRILLERS LOG

4/25, 1981 St. Cecil & Howells George
date well completed firm name county well located


LANDOWNER: Donald James
Lueda Miss

description of formations encountered	from	to
Gravel	0	2
Reds dirt	2	8
Red clay	8	19
Gravel	19	36
Blue clay	36	147
Dark sand	147	167
Blue clay	167	194
Sand	194	205

(mailing address)
WELL LOCATION:
sec. 15 T. 25 N. R. 7
5 miles S/W of Lueda
(distance) (direction) (nearest town)

WELL PURPOSE: Home
(home, irrigation, municipal, industrial)

- WELL COMPLETION DATA:
- (1) diameter (inches) 2 1/2
 - (2) total depth (feet) 205
 - (3) static water level (feet) 45 ^(below) _{above} top of ground
 - (4) casing Plastic 205
(material) (depth)
(size) If telescope see back.
 - (5) screen 5 ft 200
(length) (depth to top)
2 1/2" Plastic
(size) (material)
 - (6) pump Electric
(HP) (yield/gpm)
(type power)
 - (7) electric log yes or no

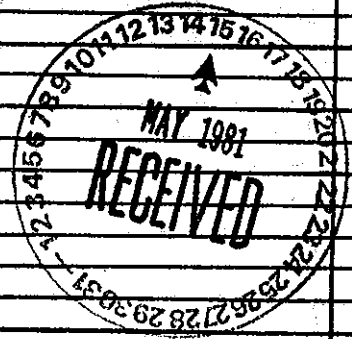

(organization running log)
(8) how well bottom plugged Back
wash down

DRILLERS REMARKS: