

GEORGE
F 2034
5/30/81
5:30

MISSISSIPPI
BOARD OF WATER COMMISSIONERS
416 North State Street
Jackson, Mississippi 39201

WATER WELL DRILLERS LOG

19 81 Cecil S. Howells George
well Sec county well located


LANDOWNER: John A. Howells
Lucedale Miss
(mailing address)

description of formations encountered	from	to
<u>Top soil</u>	<u>0</u>	<u>2</u>
<u>Red dirt</u>	<u>2</u>	<u>10</u>
<u>Red clay</u>	<u>10</u>	<u>19</u>
<u>Red sand</u>	<u>19</u>	<u>25</u>
<u>Black clay</u>	<u>25</u>	<u>27</u>
<u>Blind</u>	<u>27</u>	<u>42</u>

WELL LOCATION:
sec 14 T 2 N R 7 E
4 miles SW of Lucedale
(distance) (direction) (nearest town)

WELL PURPOSE: Home
(home, irrigation, municipal, industrial)

- WELL COMPLETION DATA:
- (1) diameter (inches) 2"
 - (2) total depth (feet) 42
 - (3) static water level (feet) 12 ^{below} _{above} top of ground
 - (4) casing Plastic 42
(material) (depth)
 - (5) screen 5 ft 31
(length) (depth to top)
 - (6) pump 2" Plastic
(size) (material)
 - (7) pump Electric 800
(type power) (yield gpm)
 - (8) electric log (yes or no) _____
 - (9) organization running log _____
 - (10) how well bottom plugged Back
wash

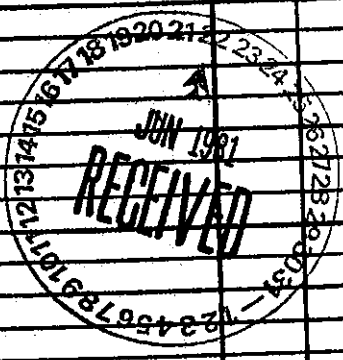

DRILLERS REMARKS: