

GEORGE  
F2635  
5/29/81

MISSISSIPPI  
BOARD OF WATER COMMISSIONERS  
416 North State Street  
Jackson, Mississippi 39201

WATER WELL DRILLERS LOG

5/30/81 date well completed  
81 Cecil S. Howells George  
27 Well name Sewick county well located


LANDOWNER: Andy Fairley  
Lucedale, Miss

description of formations encountered	from	to
Top Soil	0	2
Red dirt	2	12
Red Clay	12	21
Silt Sand	21	28
Yellow Clay	28	34
Sand	34	84

(mailing address)  
WELL LOCATION:  
24 sec. 2 T 2 N R 7 E  
5 miles 3/4 W Lucedale  
(distance) (direction) (nearest town)

WELL PURPOSE: Home  
(home, irrigation, municipal, industrial)

- WELL COMPLETION DATA:
- (1) diameter (inches) 2"
  - (2) total depth (feet) 84
  - (3) static water level (feet) 72 below top of ground
  - (4) casing (material) Plastic 84 (depth)
  - (size) If telescope see back.
  - (5) screen 5' x 1/4" (length) (depth to top)  
2" Plastic (size) (material)
  - (6) pump 1 HP Electric (type power) (yield gpm)
  - (7) electric log (yes or no)

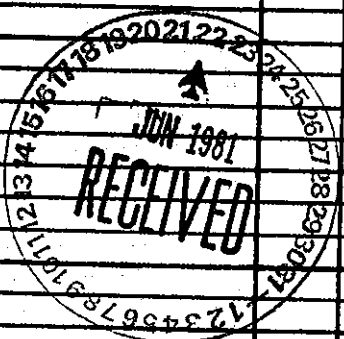

(organization running log)  
(8) how well/bottom plugged Back Wash valve

DRILLERS REMARKS: