

George
F 2038
6-24-81

MISSISSIPPI
BOARD OF WATER COMMISSIONERS
416 North State Street
Jackson, Mississippi 39201

WATER WELL DRILLERS LOG

6-24 1981 Pierce Drilling Co. George
date well completed firm name county well located

LANDOWNER: Mitchell Erhart

description of formations encountered

from to

Rt 6 Box 669

Lucedale, Ms
(mailing address)

TOP Soil
Sand
Clay
Good Sand

0 10
10 25
25 230
230 250

WELL LOCATION:


sec. 12 T 2 N R 7 E
3 West of Lucedale
(distance) (direction) (nearest town)

WELL PURPOSE:

(home) Irrigation, municipal, industrial

WELL COMPLETION DATA:

- (1) diameter (inches) 2"
- (2) total depth (feet) 250'
- (3) static water level (feet) 130' below top of ground.
- (4) casing Plastic, 240'
(material) (depth)
- 0 If telescope see back.
(size)
- (5) screen 10' 250'
(length) (depth to top)
- old Plastic
(size) (material)
- (6) pump 2 4
(HP) (yield gpm)
- Electric
(type power)
- (7) electric log (yes or no)
- (organization running log)
- (8) how well bottom plugged BW

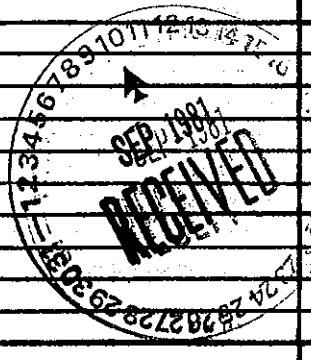

DRILLERS REMARKS: