

GEORGE  
F 2066

MISSISSIPPI DEPARTMENT OF NATURAL RESOURCES

Bureau of Land and Water Resources

Southport Mall

P.O. Box 10631

Jackson, Mississippi 39209

WATER WELL DRILLERS LOG

8-14-1956 *Sp. Force Drilling Co.* *Dege*  
 date well completed firm name county well located

LANDOWNER: *Robert Eulanks*

| description of formations encountered | from to    |            |
|---------------------------------------|------------|------------|
|                                       |            |            |
| <i>Top Soil</i>                       | <i>0</i>   | <i>10</i>  |
| <i>Sand &amp; Clay</i>                | <i>10</i>  | <i>20</i>  |
| <i>good Sand</i>                      | <i>20</i>  | <i>45</i>  |
| <i>Clay</i>                           | <i>45</i>  | <i>230</i> |
| <i>good Sand</i>                      | <i>230</i> | <i>250</i> |


*Lucedale, Ms*  
 (mailing address)

WELL LOCATION:  
 sec. *16* T. *2* N. R. *7* E  
*8* miles *West* of *Agrieta*  
 (distance) (direction) (nearest town)

WELL PURPOSE:  
 (home, irrigation, municipal, industrial)

WELL COMPLETION DATA:

- (1) diameter (inches) *4"*
- (2) total depth (feet) *250'*
- (3) static water level (feet) *100* <sup>below</sup> top of ground.
- (4) casing *plastic*, *230'*  
 (material) (depth)  
*0* If telescope see back.  
 (size)
- (5) screen *20'*, *250'*  
 (length) (depth to top)  
*006*, *plastic*  
 (size) (material)
- (6) pump *1* *25*  
 (HP) (yield gpm)  
*electric*  
 (type power)
- (7) electric log  (yes or no)
- (organization running log)
- (8) how well bottom plugged *BW*

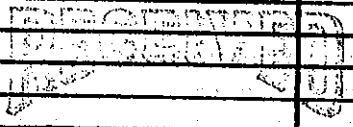

OCT 13 1956

Department of Natural Resources  
 Bureau of Land & Water Resources

DRILLERS REMARKS: