

GEORGE  
F 2067

MISSISSIPPI DEPARTMENT OF NATURAL RESOURCES

Bureau of Land and Water Resources

Southport Mall


P.O. Box 10631

Jackson, Mississippi 39209

WATER WELL DRILLERS LOG

9-16-19 St. Peice Drilling Co George  
date well completed firm name county well located

LANDOWNER: <u>Robby Farley</u>	description of formations encountered	from	to
<u>Lucedale, Ms.</u> (mailing address)			
WELL LOCATION: sec. <u>2</u> T. <u>2</u> N. R. <u>7</u> E. <u>9</u> miles <u>West</u> of <u>Lucedale</u> (distance) (direction) (nearest town)	<u>top soil</u>	<u>0</u>	<u>10</u>
	<u>Sand &amp; Clay</u>	<u>10</u>	<u>20</u>
	<u>Clay</u>	<u>20</u>	<u>170</u>
	<u>good Sand</u>	<u>170</u>	<u>190</u>
WELL PURPOSE: (home, irrigation, municipal, industrial)			
WELL COMPLETION DATA:			
(1) diameter (inches) <u>2"</u>			
(2) total depth (feet) <u>190'</u>			
(3) static water level (feet) <u>90'</u> <u>below</u> top of ground.			
(4) casing <u>plastic</u> , <u>180'</u> (material) (depth)			
<u>0</u> if telescope see back. (size)			
(5) screen <u>10'</u> , <u>190'</u> (length) (depth to top)			
<u>006</u> , <u>plastic</u> (size) (material)			
(6) pump <u>2</u> <u>8</u> (HP) (yield gpm)			
<u>electric</u> (type power)			
(7) electric log (yes or <u>no</u> )			
(organization running log)			
(8) how well bottom plugged <u>BW</u>			
DRILLERS REMARKS:			

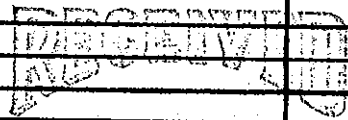

Department of Natural Resources  
Bureau of Land & Water Resources