

MISSISSIPPI DEPARTMENT OF NATURAL RESOURCES

Bureau of Land and Water Resources

Southport Mall

P.O. Box 10631


Jackson, Mississippi 39209

WATER WELL DRILLERS LOG

George
F 2268

9-23-80 date well completed Perce Drilling Co. firm name George county well located

LANDOWNER: <u>Stanton Fairley</u>	description of formations encountered	from	to						
<u>Acucala Ms</u> (mailing address)	<u>Top Soil</u>	<u>0</u>	<u>10</u>						
	<u>Sand + Clay</u>	<u>10</u>	<u>30</u>						
	<u>good sand</u>	<u>30</u>	<u>70</u>						
WELL LOCATION:									
sec. <u>23</u> T- <u>2</u> N R- <u>7</u> E									
<table border="0"> <tr> <td><u>10</u> miles</td> <td><u>NW</u></td> <td>of <u>Acucala</u></td> </tr> <tr> <td>(distance)</td> <td>(direction)</td> <td>(nearest town)</td> </tr> </table>				<u>10</u> miles	<u>NW</u>	of <u>Acucala</u>	(distance)	(direction)	(nearest town)
<u>10</u> miles	<u>NW</u>	of <u>Acucala</u>							
(distance)	(direction)	(nearest town)							
WELL PURPOSE: (home, irrigation, municipal, industrial)									
WELL COMPLETION DATA:									
(1) diameter (inches) <u>2"</u>									
(2) total depth (feet) <u>70'</u>									
(3) static water level (feet) <u>30'</u> <u>below</u> above top of ground.									
(4) casing <u>plastic</u> , <u>60'</u> (material) (depth)									
<u>0</u> If telescope see back. (size)									
(5) screen <u>10'</u> , <u>70'</u> (length) (depth to top)									
<u>006</u> , <u>plastic</u> (size) (material)									
(6) pump <u>1</u> (HP) <u>12</u> (yield gpm)									
<u>electric</u> (type power)									
(7) electric log (yes or no) <u>no</u>									
(organization running log)									
(8) how well bottom plugged <u>BW</u>									
DRILLERS REMARKS:									

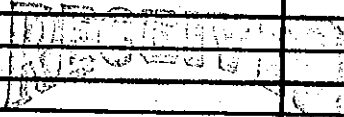

OCT 15 1980

Department of Natural Resources
Bureau of Land & Water Resources