

George
 585
 5-28-81

MISSISSIPPI
 BOARD OF WATER COMMISSIONERS
 416 North State Street
 Jackson, Mississippi 39201

CODED

WATER WELL DRILLERS LOG

5/28/81 date well completed
 81 Cecil S. Howells Dr. George county well located
 Water firm Drill Ser

LANDOWNER: A.C. Brooks
Lucedale, Miss
 (mailing address)

description of formations encountered	from	to
Top soil	0	2
Red dirt	2	10
Red clay	10	19
Sand	19	31
Yellow clay	31	65
Orange clay	65	91
Blue clay	91	289
Sand	289	312

WELL LOCATION:
 sec. 8 T. 2 N. R. 6 E.
1 miles S Lucedale
 (distance) (direction) (nearest town)

WELL PURPOSE: Irrigation
 (home, irrigation, municipal, industrial)

WELL COMPLETION DATA:

(1) diameter (inches) 4"

(2) total depth (feet) 312

(3) static water level (feet) 93 below top of ground above

(4) casing Plastic 312
 (material) (depth)


_____ If telescope see back.
 (size)

(5) screen 107 302
 (length) (depth to top)
2" Plastic
 (size) (material)

(6) pump 3 sub 60
Electric (type power) (yield gpm)

(7) electric log _____
 (organization running log)

(8) how well bottom plugged Back
wash valve

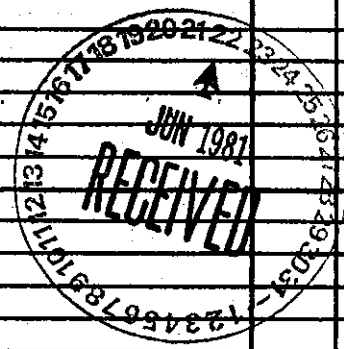

DRILLERS REMARKS: