

State Well Report

Part 1 - Driller's Log

Mississippi Department of Environmental Quality
Office of Land and Water Resources
P.O. Box 2307
Jackson, MS 39225
(601)961- 5210
(601)961- 5228 (fax)

County: George
Permit #: _____
Driller: Mikes + Wade
Date drilling completed: 5-4-10

For Office Use Only:
Aquifer: G 177
Well #: _____
L. S. Elevation: _____
E-log #: _____

State Law requires that this report be prepared by the license holder responsible for the work and filed with the Department at the above address within 30 days of completion of drilling of the well or borehole.

Information on Well Owner (Landowner if borehole is not for a water well)	Well or Borehole Location
Owner Name: <u>Ronald Children</u>	Latitude: <u>30° 51' 50.43"</u> Longitude: <u>88° 36' 18.09"</u>
Mailing Address: <u>23081 Hwy 98</u>	Method of Lat/Long (circle one): Conventional Survey, <u>GN</u> USGS quad, Hand-held GPS, Survey-grade GPS
<u>Lucedale MS 39452</u>	<u>N 1/4 N 6 1/4 Sec 20 Twn T25 Rng R6W</u>
City State Zip Code	Distance Direction Nearest Town
Telephone No. ()	<u>2 1/2 Miles S of Lucedale</u>

Well / Borehole Data

Date drilling started: 5-4-10 Date drilling completed: 5-4-10 Hole depth: 120 Hole diameter: 8 1/2

Location of the source of any surface water used for drilling: NONE

Method of dosing and volume of Chlorine used in drilling and development: _____

Logs run (circle all applicable): No log run Electric Gamma Ray Density Sonic Neutron Other: _____

Name of organization running log(s): _____

Purpose of borehole (check one): Water Well Geotechnical/Geological Investigation Ground Source Heat Pump
Seismic Survey Other (describe) _____

If drilling is not related to water well construction, skip the remainder of this block

Purpose of Well (check one): Home Industrial Public Supply Irrigation Fish Culture Other: _____

If a flowing well, method of flow regulation: Valve _____ Other (describe) _____

Static Water Level: 45 feet above or below (circle one) land surface Date measured: _____

Method of Measurement (circle one) steel tape electric tape air line other: _____

Well depth: 120 Well grouted to a depth of 10 feet Type of grout (circle one): Neat Cement Bentonite Mix

Casing length: 100 feet Casing diameter: 4 inches Type of casing: PUC 40

Screen length: 20 feet Screen diameter: 4 inches Type of screen: PUC wrapped

Screen slot size: 12 inches Setting depth: From 100 feet to 120 feet

Type of completion (circle all applicable): Gravel packed Underreamed Telescoped Open hole Natural Development
Other (describe): _____

Top of lap pipe or reduction in casing: _____ feet. **If telescoped or more than one screen, describe on next page**

Form: OLWR-SWR-1A (04/08)

RECEIVED
MAY 25 2010
BY: OLWR

6177

The sketch below only required for water wells

Description of formations encountered must be provided for all wells and boreholes, unless specifically exempted by regulations


If well telescopes, show depths on sketch

Ground Level →

Description of Formations Encountered	From (depth)	To (depth)
	Ground Level	
Clay	0	4
sand	4	18
Clay	18	32
sand	32	82
Clay	82	92
sand	92	120

If more than one screen, show location of each on sketch

Sketch the property layout and include the following: 1) the well location; 2) any permanent structures on the property that may aid in locating the well; 3) any roads, power lines, or other items that may aid in locating the property and the well; 4) a north arrow.

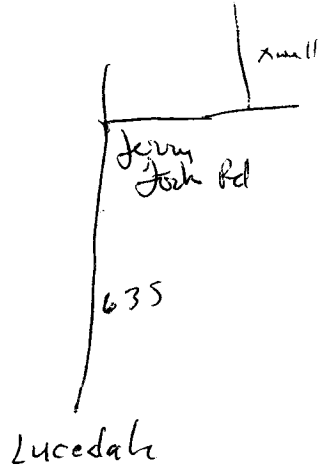

Landowner Name: Ronald Childress

Form: OLWR-SWR-1A (04/08)

I certify that the well/borehole was drilled, constructed, and completed in accordance with all applicable requirements of the Mississippi Department of Environmental Quality and the Mississippi Department of Health regulations, if applicable, and state laws.

Michael R FeyFogel 0408 5-4-10
 Print Name of Responsible Licensee and License No. Date

Michael R FeyFogel
 Signature of Licensee

RECEIVED
 MAY 25 2010
 BY OLWR

STATE WELL REPORT

Part 2

Pump Installer's Completion Report
 Mississippi Department of Environmental Quality
 Office of Land and Water Resources
 P.O. Box 2309
 Jackson, MS 39225
 (601)961-5210
 (601)961-5228 (fax)

For Office Use Only:

Aquifer: 6177
 Well #: _____
 Elevation: _____

County: George
 Permit #: _____
 Driller: Mkt & Wade
 Date completed: 5-11-10
Copy information from block on Part 1

This part of the report must be completed by a licensed water well contractor or a licensed pump installer. A copy of Part 1 of the report must be attached and both parts filed with the Department at the above address within 30 days of well completion.

Well Owner Information	Well Location
Owner Name: <u>Ronald Children</u>	Latitude: _____ Longitude: _____
Mailing Address: <u>33081 Hwy 98</u>	Method of Lat/Long (check one): Conventional Survey _____
<u>Lucedale Ms 39452</u>	USGS quad _____, Hand-held GPS _____, Survey-grade GPS _____
City State Zip Code	_____ ¼ _____ ¼ Sec <u>20</u> T <u>T25</u> R <u>R6W</u>
Telephone No. () _____	Distance Direction Nearest Town
	<u>2 1/2</u> Miles <u>S</u> of <u>Lucedale</u>

Pump Type Circle one	Power Type Circle one
Air Lift Jet <u>Submersible</u>	Diesel Engine Gasoline Engine Natural Gas
Bucket Piston Turbine	<u>Electric Motor</u> Hand Tractor PTO
Centrifugal Rotary Flowing Well	Windmill Other (specify): _____
Other (specify): _____	Horse Power Rating of Motor: <u>7 1/2</u>
Date Pump Installed: <u>5-11-10</u>	Setting Depth: <u>120</u> feet
Rated Pump Capacity: <u>85</u> Gallons Per Minute	Number of Stages: <u>15</u>

Pump Test Data	Method of Measuring Water Level Circle one
Date Well Tested: <u>5-11-10</u>	<u>Air Line</u> Electric Measuring Line Steel Tape
Static Water Level (A): <u>45</u> Feet Below Land Surface	Other (specify): _____
Pumping Water Level (B): <u>70</u> Feet Below Land Surface	For flowing well, measured shut in head: _____ feet
Drawdown [(B) - (A)]: <u>25</u> Feet Below Land Surface	Well yielded <u>100</u> GPM with a drawdown of
Test Pumping Rate: <u>100</u> Gallons Per Minute	<u>25</u> feet after <u>1 1/2</u> hours of pumping
Duration of Pump Test (minimum 4 hours): <u>4</u> hours	

I HEREBY CERTIFY that the above statements are true to the best of my knowledge.

Michael R Fryfog 120408 Michael R Fryfog
 Print Name of Pump Installer and License No. (if applicable) Signature of Pump Installer

RECEIVED
 MAY 25 2010
 BY: OLWR