

State Well Report

Part 1

Mississippi Department of Environmental Quality
Office of Land and Water Resources
P.O. Box 10631
Jackson, MS 39289-0631
(601) 961-5210
(601) 354-6938 (fax)

For Office Use Only:

Aquifer: 6191
Well #: _____
L. S. Elevation: _____
E-log #: _____

County: George
Permit #: _____
Driller: Coast Water Well Serv.
Date drilling completed: 7/6/12

State Law requires that this report be prepared by the driller in detail and filed with the Department within 30 days of completion of drilling of the well.

Well Owner Information	Well Location
Owner Name: <u>Randy Von Kanel</u>	Latitude: <u>30.49.5244</u> Longitude: <u>088.33.4632</u>
Mailing Address: <u>Gravin Chuachwell Road</u>	Method of Lat/Long (circle one): Conventional Survey, USGS quad <u>Hand-held GPS</u> , Survey-grade GPS
<u>Lucedale, MS 39452</u>	<u>S</u> 1/4 <u>S</u> 1/4 Sec <u>26</u> Twn <u>T25</u> Rng <u>R6W</u>
City State Zip Code	Distance <u>NW</u> Direction <u>35</u> Nearest Town <u>Agicola</u>
Telephone No. () _____	<u>3</u> Miles <u>NW</u> of _____

Well Data

Purpose of Well (circle one) Home Industrial Public Supply Irrigation Fish Culture Other: _____

Date well drilling started: 7/3/12 Date well drilling completed: 7/6/12

If flowing, method of flow regulation: Valve N/A Other (describe) _____

Static Water Level: 115 feet above or below (circle one) land surface Date measured: 7/6/12

Method of Measurement (circle one) steel tape electric tape air line other: _____

Hole depth: 393 FT Well depth: 393 FT Well grouted to a depth of 10 feet

Type of grout (circle one): Cement Bentonite Mix

Casing length: 260' x 4" feet Casing diameter: 4 x 2 inches Type of casing: PVC

Screen length: 20 feet Screen diameter: 2 inches Type of screen: PVC

Screen slot size: .006 inches Setting depth: From 373 feet to 393 feet

Type of completion (circle all applicable): Gravel packed Underreamed Telescoped Open hole Natural Development

Other (describe): _____

Top of lap pipe or reduction in casing: N/A feet. If telescoped or more than one screen, describe on back of page


Logs run (circle all applicable): No log run Electric Gamma Ray Density Sonic Neutron Other: _____

Name of organization running log(s): N/A

I certify that the well was drilled, constructed, and completed in accordance with all applicable requirements of the Mississippi Department of Environmental Quality and/or the Mississippi Department of Health regulations and state laws.

Jack Ridgell 0-472 _____
Print Name of Water Well Contractor and License No. Signature of Water Well Contractor


If well telescopes please sketch below and show depths.

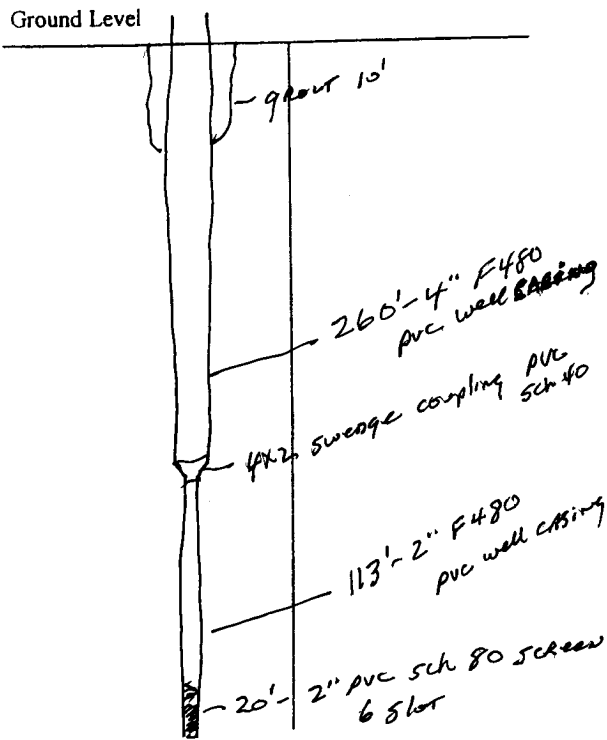

Description of Formations Encountered	From	To
Top Soil	0	2
Orange Dirt	2	18
Orange Coarse Sand	18	35
Orange and White Clay	35	95
Gray Coarse Sand	95	124
Blue Clay	124	235
Gray Coarse Sand w/ streaks of Sand	235	270
Gray Coarse Sand	270	297
Blue Clay	297	365
Gray Coarse Sand	365	393

If more than one screen, show location of each on sketch

Sketch the property layout and include the following: 1) the well location; 2) any permanent structures on the property that may aid in locating the well; 3) any roads, power lines, or other items that may aid in locating the property and the well; 4) indicate direction.

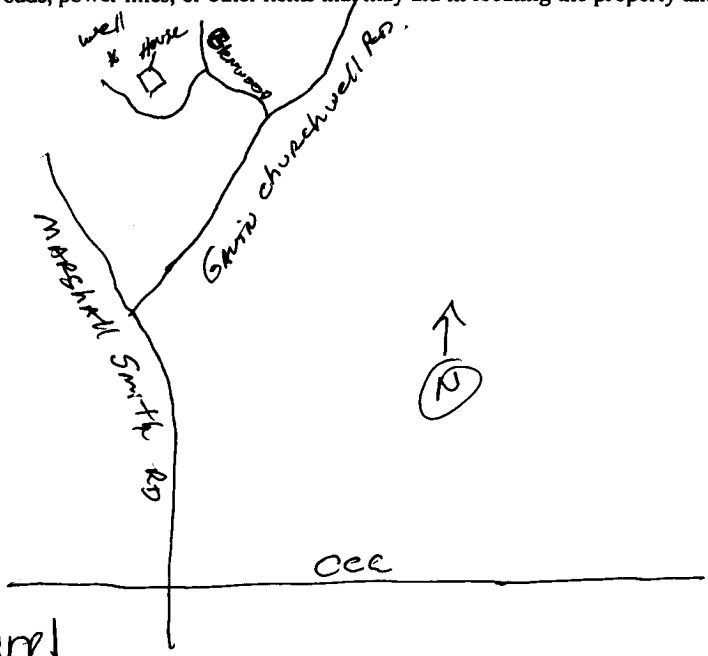

Landowner Name: Bandy Von Karel

Signature of Water Well Contractor

RECEIVED
JUL 25 2012
BY
Lewis Printing - Pascagoula, MS

G191

STATE WELL REPORT

Part 2

Pump Installer's Completion Report
 Mississippi Department of Environmental Quality
 Office of Land and Water Resources
 P.O. Box 10631
 Jackson, MS 39289-0631
 (601) 961-5210
 (601) 354-6938 (fax)

For Office Use Only:

Aquifer: _____
 Well #: _____
 Elevation: _____

County: George
 Permit #: _____
 Driller: Coast Water Wells Serv
 Date completed: 7/6/12

This report should be prepared by the pump installer in detail and filed with the Department within 30 days of the installation of pump.

Well Owner Information	Well Location
Owner Name: <u>Randy Von Kanel</u>	Latitude: <u>30°49'52.41"</u> Longitude: <u>088°33'46.32"</u>
Mailing Address: <u>GALEN Churchwell Road</u>	Method of Lat/Long (circle one): Conventional Survey, USGS quad, <u>Hand-held GPS</u> , Survey-grade GPS
<u>Lucedale, MS 39452</u>	<u>SW 1/4 SW 1/4 Sec 26 Twn 22 S Rng R 6 W</u>
City State Zip Code	Distance <u>NW</u> Direction <u>35</u> Nearest Town
Telephone No. () _____	<u>3</u> Miles <u>NW</u> of <u>Agreston</u>

Pump Type Circle one	Power Type Circle one
Air Lift Jet <u>Submersible</u>	Diesel Engine Gasoline Engine Natural Gas
Bucket Piston Turbine	<u>Electric Motor</u> Hand Tractor PTO
Centrifugal Rotary Flowing Well	Windmill Other (specify): _____
Other (specify): _____	Horse Power Rating of Motor: <u>2 HP</u>
Date Pump Installed: <u>7/11/12</u>	Setting Depth: <u>200 FT. Drop Pipe</u> feet
Rated Pump Capacity: <u>20</u> Gallons Per Minute	Number of Stages: <u>14</u>

Pump Test Data	Method of Measuring Water Level Circle one
Date Well Tested: <u>7/11/12</u>	<u>Air Line</u> Electric Measuring Line Steel Tape
Static Water Level (A): <u>115</u> Feet Below Land Surface	Other (specify): _____
Pumping Water Level (B): <u>N/A</u> Feet Below Land Surface	For flowing well, measured shut in head: <u>N/A</u> feet
Drawdown [(B) - (A)]: <u>N/A</u> Feet Below Land Surface	Well yielded <u>40</u> GPM with a drawdown of
Test Pumping Rate: <u>22</u> Gallons Per Minute	<u>N/A</u> feet after <u>N/A</u> hours of pumping
Duration of Pump Test (minimum 4 hours): <u>5</u> hours	

I HEREBY CERTIFY that the above statements are true to the best of my knowledge.
Jack Ridgell 0-472
 Print Name of Pump Installer and License No. (if applicable)
Jack Ridgell
 Signature of Pump Installer