

State Well Report

Part 1 - Driller's Log

Mississippi Department of Environmental Quality
Office of Land and Water Resources
P.O. Box 2307
Jackson, MS 39225
(601)961- 5210
(601)961- 5228 (fax)

County: DeKalb
Permit #: 0-780
Driller: Joel Pinner
Date drilling completed: 5-23-08

For Office Use Only:
Aquifer: _____
Well #: H-109
L. S. Elevation: 6200
E-log #: _____

State Law requires that this report be prepared by the license holder responsible for the work and filed with the Department at the above address within 30 days of completion of drilling of the well or borehole.

Information on Well Owner <i>(Landowner if borehole is not for a water well)</i>	Well or Borehole Location
Owner Name: <u>Jeremy L. Lundy</u>	Latitude: <u>88° 32' 635"</u> Longitude: <u>30° 51' 818"</u>
Mailing Address: <u>104 Easley Rd</u>	Method of Lat/Long (circle one): Conventional Survey, <u>02</u> <u>49</u>
<u>Lumbah MS 39458</u>	USGS quad, <u>Hand-held GPS</u> , Survey-grade GPS
City State Zip Code	<u>NE</u> 1/4 <u>NE</u> 1/4 Sec <u>24</u> Twn <u>25</u> Rng <u>8W</u>
Telephone No. <u>601</u> ²²⁸ <u>588-6447</u>	Distance Direction Nearest Town <u>5</u> Miles <u>NE</u> of <u>Agada, MS</u>

Well / Borehole Data

Date drilling started: 5-23 Date drilling completed: 5-23-08 Hole depth: 90 Hole diameter: 2

Location of the source of any surface water used for drilling: Agada, MS

Method of dosing and volume of Chlorine used in drilling and development: equal chlorine 2000 water

Logs run (circle all applicable): No log run Electric Gamma Ray Density Sonic Neutron Other: _____

Name of organization running log(s): _____

Purpose of borehole (check one): Water Well Geotechnical/Geological Investigation _____ Ground Source Heat Pump _____

Seismic Survey _____ Other (describe) _____

If drilling is not related to water well construction, skip the remainder of this block

Purpose of Well (check one): Home Industrial _____ Public Supply _____ Irrigation _____ Fish Culture _____ Other: _____

If a flowing well, method of flow regulation: Valve _____ Other (describe) _____

Static Water Level: 4 feet above below (circle one) land surface Date measured: 5-23-08

Method of Measurement (circle one) steel tape electric tape air line other: _____

Well depth: 90 Well grouted to a depth of 10 feet Type of grout (circle one): Neat Cement Bentonite Mix

Casing length: 80 feet Casing diameter: 2 inches Type of casing: Sch 40 Plastic

Screen length: 10 feet Screen diameter: 2 inches Type of screen: Sch 80

Screen slot size: 6 inches Setting depth: From 0 feet to 90 feet

Type of completion (circle all applicable): Gravel packed Underreamed Telescoped Open hole Natural Development

Other (describe): _____

Top of lap pipe or reduction in casing: _____ feet. ***If telescoped or more than one screen, describe on next page***


Form: OLWR-SWR-1A (04/08)

RECEIVED
JUN 13 2008
BY: OLWR

H-109

The sketch below only required for water wells


If well telescopes, show depths on sketch.

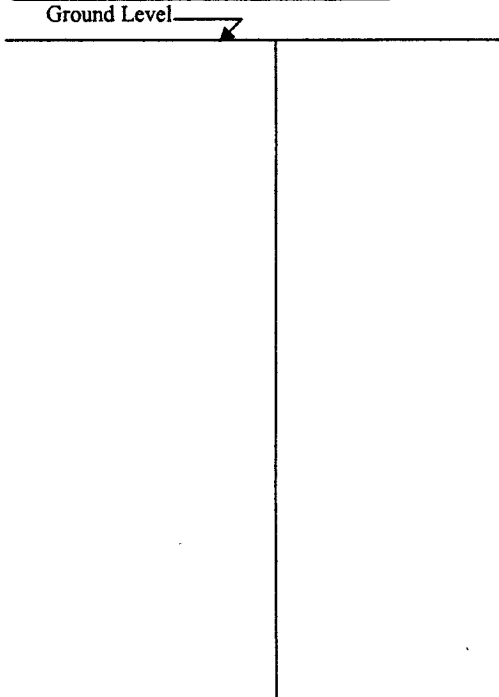

Description of formations encountered must be provided for all wells and boreholes, unless specifically exempted by regulations

Description of Formations Encountered	From (depth) Ground Level	To (depth)
Red Sand	0	20
yellow clay	20	25
white Sand	25	90

If more than one screen, show location of each on sketch

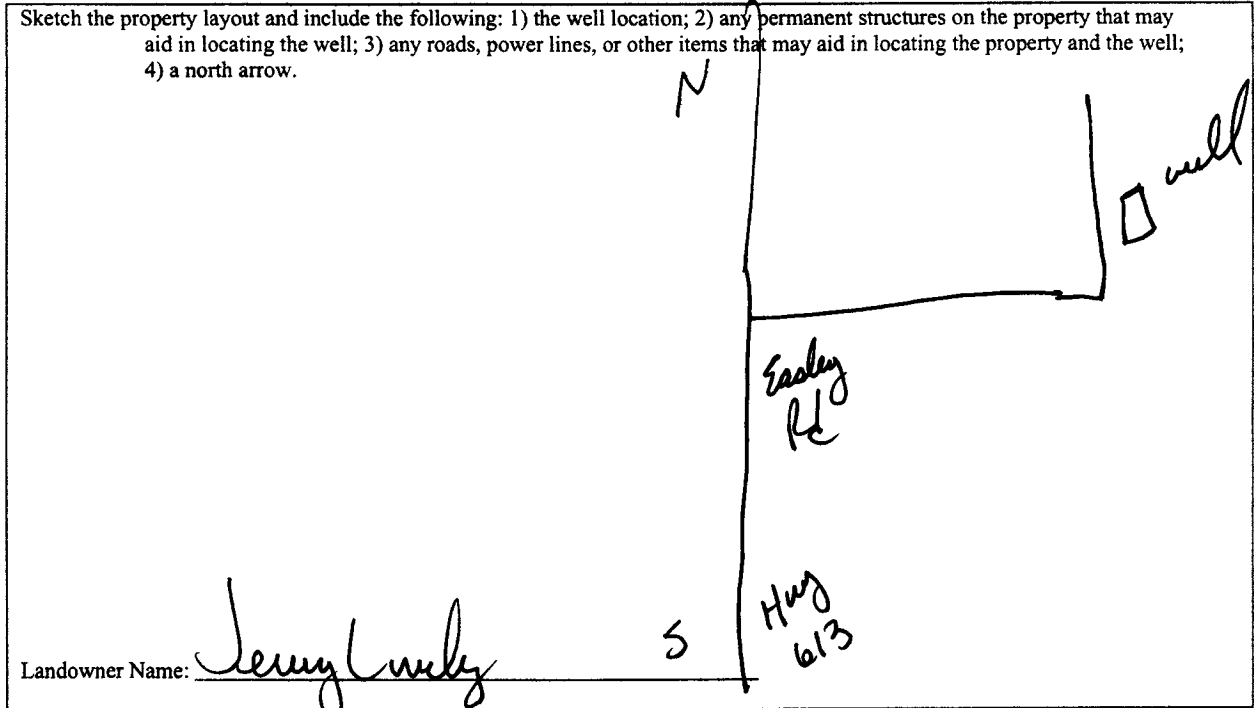

Form: OLWR-SWR-1A (04/08)

I certify that the well/borehole was drilled, constructed, and completed in accordance with all applicable requirements of the Mississippi Department of Environmental Quality and the Mississippi Department of Health regulations, if applicable, and state laws.

Joel Pinner 0-780 5-23-08
 Print Name of Responsible Licensee and License No. Date

[Signature]
 Signature of Licensee

RECEIVED
 JUN 19 2008
 BY: OLWR

STATE WELL REPORT

Part 2

Pump Installer's Completion Report
 Mississippi Department of Environmental Quality
 Office of Land and Water Resources
 P.O. Box 2309
 Jackson, MS 39225
 (601)961-5210
 (601)961-5228 (fax)

County: George
 Permit #: 0-780
 Driller: Joel Pinn
 Date completed: 5-23-08
Copy information from block on Part 1

For Office Use Only:

Aquifer: G-200
 Well #: H-109
 Elevation: _____

This part of the report must be completed by a licensed water well contractor or a licensed pump installer. A copy of Part 1 of the report must be attached and both parts filed with the Department at the above address within 30 days of well completion.

Well Owner Information	Well Location
Owner Name: <u>Jerry Cuddy</u>	Latitude: <u>88 32 635</u> Longitude: <u>30 51 818</u>
Mailing Address: <u>609 Easley Rd</u>	Method of Lat/Long (check one): Conventional Survey _____
<u>Cumada</u> <u>ms</u> <u>39457</u>	USGS quad _____, Hand-held GPS <input checked="" type="checkbox"/> , Survey-grade GPS _____
City State Zip Code	<u>NE</u> ¼ <u>NE</u> ¼ Sec <u>24</u> T <u>25</u> R <u>50</u>
Telephone No. <u>(228) 588-6447</u>	Distance Direction Nearest Town
	<u>5</u> Miles <u>NE</u> of <u>Acula, ms</u>

Pump Type Circle one	Power Type Circle one
Air Lift <input type="checkbox"/> Jet <input checked="" type="checkbox"/> Submersible	Diesel Engine Gasoline Engine Natural Gas
Bucket Piston Turbine	<input checked="" type="checkbox"/> Electric Motor Hand Tractor PTO
Centrifugal Rotary Flowing Well	Windmill Other (specify): _____
Other (specify): _____	Horse Power Rating of Motor: <u>1</u>
Date Pump Installed: <u>5-23-08</u>	Setting Depth: <u>60 ft line</u> feet
Rated Pump Capacity: <u>10</u> Gallons Per Minute	Number of Stages: <u>2</u>

Pump Test Data	Method of Measuring Water Level Circle one
Date Well Tested: <u>5-23-08</u>	<input checked="" type="checkbox"/> Air Line Electric Measuring Line Steel Tape
Static Water Level (A): <u>4</u> Feet Below Land Surface	Other (specify): _____
Pumping Water Level (B): <u>60</u> Feet Below Land Surface	For flowing well, measured shut in head: _____ feet
Drawdown [(B) - (A)]: <u>2</u> Feet Below Land Surface	Well yielded <u>10</u> GPM with a drawdown of
Test Pumping Rate: <u>10</u> Gallons Per Minute	<u>2</u> feet after <u>48</u> hours of pumping
Duration of Pump Test (minimum 4 hours): <u>48</u> hours	

I HEREBY CERTIFY that the above statements are true to the best of my knowledge.

Joel Pinn 0-780 Joel Pinn
 Print Name of Pump Installer and License No. (if applicable) Signature of Pump Installer

Form **RECEIVED** OLWR-SWR-VTDW/08

JUN 19 2008
 BY: OLWR