STATE WELL REPORT						
County: George Permit #:	D Mississippi Depart Office of La Jacks ((60 be prepared by the bithin 30 days of con a water well) COMERY	Part 1 priller's Log ment of Environmental Quality and and Water Resources P.O. Box 2309 on, MS 39225-2309 (601)961-5555 1)961-5228 (fax) license holder responsible for the mpletion of drilling of the well of Well or Bore Latitude: <u>30.8852070</u> Lor Method of Lat/Long (check one	he work and filed with or borehole. hole Location ngitude: <u>-88.6168</u>): Conventional Surve	RECEIVED , the 10-05-202 BY OLW 3430		
Lucedale Ms City State Telephone No. ()	39452 Zip Code	USGS quad, Hand-held G <u>NE</u> 1/4 <u>SE</u> 1/4, Sec 7 <u>3</u> Miles <u>SW</u> 0 (Distance) (Direction)	7F	. <u>6W</u>		
Well / Borehole Data Date drilling started: 09/26/2021 Date drilling completed: 09/26/2021 Hole depth: 72 Hole diameter: 71/4 Location of the source of any surface water used for drilling: None None Method of dosing and volume of Chlorine used in drilling and development:						
Purpose of Well (check all applicable): Other (describe): If a flowing well, method of flow regul Static Water Level: <u>25</u> feet Method of measurement (check one): Well depth: <u>72</u> Well grouted to a Casing length: <u>62</u> feet Ca Screen length: <u>10</u> feet S Screen slot size: <u>.08</u> inches Type of completion (check all applicable Other (describe): Top of lap pipe or reduction in casing:	ation: Valve [above or 🗹 belo (check one) Steel tape Electric depth of: <u>10</u> f asing diameter: <u>4</u> Setting depth: e): Gravel packed	Other (describe) ow] land surface Date measur tape Air line ☑Other (describe) feet Type of grout (check one):	ed: _09/26/202 : Neat Cement Bento :asing: Sch 40 screen: Wrap 5.72f Natural Developme	1 nite Mix eet		
If telescoped or more than one screen, describe on next page						

County:	George
Dormit #	
Permit #:	



For Office Use Only:

The sketch below only required for water wells

If well telescopes, show depths on sketch.

K

Ground Level

Description of formations encountered must be provided for all wells and boreholes, unless specifically exempted by regulations


Well #: _____G238

Description of Formations Encountered	From (depth)	To (depth)
Mix	Ground level	15
Clay	15	48
Sand	48	72
		•

If more than one screen, show location of each on sketch

Sketch the property layout and include the following:

- 1) the well location
- 2) any permanent structures on the property that may aid in locating the well
- 3) any roads, power lines, or other items that may aid in locating the property and the well
- 4) north arrow

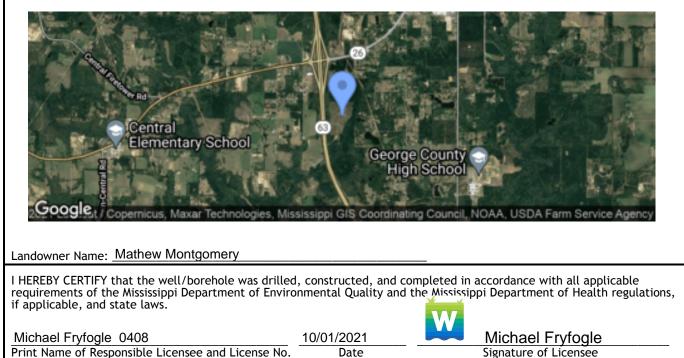

Form: OLWR-SWR-1B (4/13)