## STATE WELL REPORT

## County: George Permit #: Driller: Michael Fryfogle Date drilling completed: 02/28/2022

## Part 1 Driller's Log

Mississippi Department of Environmental Quality
Office of Land and Water Resources
P.O. Box 2309
Jackson, MS 39225-2309
(601)961-5555

Well #: G253

Aquifer: \_\_\_\_\_\_

E-Log #: \_\_\_\_\_

For Office Use Only:

Elev 205

(601)961-5228 (fax)

State Law requires that this report be prepared by the license holder responsible for the work and filed with the Department at the above address within 30 days of completion of drilling of the well or borehole.

Well Owner Information (Landowner if borehole is not for a water well)			Well or Borehole Location Latitude: 30.8864340 Longitude: -88.6163680		
Owner Name: N	ick Prassenos				
Mailing Address:	178 Saddleba	ck In	Method of Lat/Long (check one): Conventional Survey,		
-			USGS quad, Hand-held GPS, Survey-grade GPS		
Lucedale	Ms	39452	$\begin{array}{c ccccccccccccccccccccccccccccccccccc$		
City	State	Zip Code	3.08 <sub>Miles</sub> SW <sub>of</sub> Lucedale		
Telephone No. (_	)		(Distance) (Direction) (Nearest Town)		

Location of the source of any surface water used for drilling:			
Method of dosing and volume of Chlorine used in drilling and development:			
Logs run (check all applicable): No log run⊡Electric Gamma Ray Density Sonic Neutron Other:			
Name of organization running log(s):			
Purpose of borehole (check one): Water Well 🗹 Geotechnical/Geological Investigation Ground Source Heat Pump			
Seismic Survey Other (describe)			
If drilling is not related to water well construction, skip the remainder of this block			
Purpose of Well (check all applicable): Home Industrial Public Supply Irrigation Fish Culture			
Other (describe):			
If a flowing well, method of flow regulation: Valve Other (describe)			
Static Water Level: 30feet [ above or [] below] land surface Date measured: 02/28/2022 (check one)			
Method of measurement (check one): Steel tape Electric tape Air line Other (describe):			
Well depth: 73 Well grouted to a depth of: 10 feet Type of grout (check one): Neat Cement Bentonite Mix			
Casing length: 63 feet Casing diameter: 4 inches Type of casing: Sch40			
Screen length: 10feet Screen diameter: 4inches Type of screen: Wrap			
Screen slot size: .08inches Setting depth: From 63feet_to 73feet			
Type of completion (check all applicable): Gravel packed ✓ Underreamed Open hole Natural Development			
Other (describe):			
Top of lap pipe or reduction in casing:feet			
If telescoped or more than one screen, describe on next page			

Form: OLWR-SWR-1A (4/13)

County:	George	
Permit #:		

RECEIVED
03-09-2022
BY OLWR

For Office Use Only:			
Well #:	G253		
_			

## The sketch below only required for water wells

If well telescopes, show depths on sketch.

Ground Level		


<u>Description of formations encountered must be provided for all wells</u> and boreholes, unless specifically exempted by regulations

Description of Formations Encountered	From ( <i>depth</i> ) Ground level	To (depth)
Clay	Ground level	12
Sand mix	12	30
Clay	30	40
Sand	40	73

If more than one screen, show location of each on sketch

Sketch the property layout and include the following:

- 1) the well location
- 2) any permanent structures on the property that may aid in locating the well
- 3) any roads, power lines, or other items that may aid in locating the property and the well
- 4) north arrow

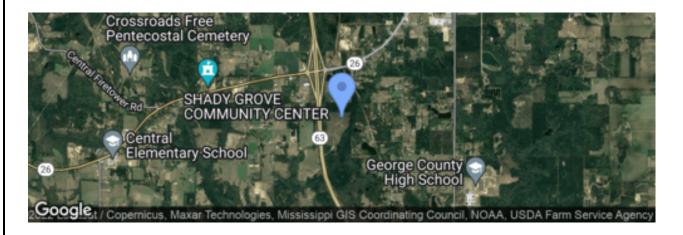

Landowner Name: Nick Prassenos

I HEREBY CERTIFY that the well/borehole was drilled, constructed, and completed in accordance with all applicable requirements of the Mississippi Department of Environmental Quality and the Mississippi Department of Health regulations, if applicable, and state laws.

Michael Fryfogle 0408

Print Name of Responsible Licensee and License No.

O3/08/2022

Michael Fryfogle

Signature of Licensee

Form: OLWR-SWR-1B (4/13)