

MISSISSIPPI DEPARTMENT OF NATURAL RESOURCES

Bureau of Land and Water Resources

Southport Mall

P.O. Box 10631


Jackson, Mississippi 39209

WATER WELL DRILLERS LOG

GEORGE  
G 7167

10-30-85 date well completed      Fryfogle Well Serv. firm name      George county well located

LANDOWNER	description of formations encountered	from	to
SUSAN LITTLE	TOP SOIL + clay	0	10
RT 2, Box 208	clay	10	20
Lucedale, MS 39452	sand	20	30
(mailing address)	clay	30	50
WELL LOCATION:	clay	50	70
sec. 2 T. 2 N. R. 6 E	SAND EXT. FINE	70	90
5 miles SE of Lucedale	clay	90	120
(distance) (direction) (nearest town)	FINE SAND	120	150
WELL PURPOSE: HOME	Hard Blue clay	150	250
(home, irrigation, municipal, industrial)	Fine to Med Blue Sand	250	292
WELL COMPLETION DATA:			
(1) diameter (inches) 4"			
(2) total depth (feet) 292			
(3) static water level (feet) 110 below top of ground.			
(4) casing PVC, 200' (material) (depth)			
4x2 (size) if telescope see back.			
(5) screen 15, 282 (length) (depth to top)			
2" PVC #10 (size) (material)			
(6) pump 1, 30 AT 140' (HP) (yield gpm)			
LECT (type power)			
(7) electric log NO (yes or no)			
NO (organization running log)			
(8) how well bottom plugged PVC BALL CHECK			
DRILLERS REMARKS:			

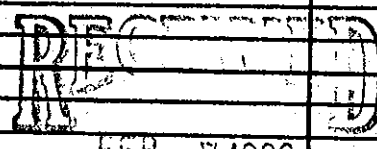

Department of Natural Resources  
Bureau of Land & Water Resources