

George  
H44  
2-15-75

MISSISSIPPI  
BOARD OF WATER COMMISSIONERS  
416 North State Street  
Jackson, Mississippi 39201

CODED

WATER WELL DRILLERS LOG

2/15 1975 Public Drilling Co. George  
date well completed firm name county well located


LANDOWNER:	description of formations encountered	from	to
<u>Clifton Taylor</u>			
<u>Ro. 2</u>	<u>TOPSOIL</u>	<u>0</u>	<u>20</u>
<u>Lucedale, Miss</u>	<u>SAND</u>	<u>20</u>	<u>40</u>
(mailing address)	<u>CLAY</u>	<u>40</u>	<u>60</u>
	<u>SAND GOOD</u>	<u>60</u>	<u>90</u>

WELL LOCATION: 13R  
sec. 31 T. 2 N R. 5 E  
5 1/2 miles SOUTH of Lucedale  
(distance) (direction) (nearest town)

WELL PURPOSE:  
(home, irrigation, municipal, industrial)

WELL COMPLETION DATA:

- (1) diameter (inches) 2"
- (2) total depth (feet) 90'
- (3) static water level (feet) 50' <sup>below</sup> <sub>above</sub> top of ground.
- (4) casing PLASTIC, 90'  
(material) (depth)  
0 If telescope see back.  
(size)
- (5) screen 10', 90'  
(length) (depth to top)  
008, PLASTIC  
(size) (material)
- (6) pump 1 8  
(HP) (yield gpm)  
5/16  
(type power)
- (7) electric log no  
(yes or no)  
(organization running log)
- (8) how well bottom plugged BLW.

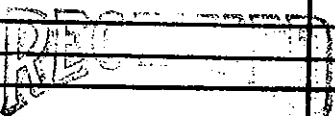

DRILLERS REMARKS: MAR - 6 1975