		7 11 10	39
		Vell Report	For Office Use Only
County: George		Part 1	A
Permit #:	Mississippi Department of Environmental Quality Office of Land and Water Resources		Aquifer:
Driller: Michal S. Havard		Box 10631	well #: <u>H - 75</u>
· · · · · · · · · · · · · · · · · · ·		MS 39289-0631	L. S. Elevation:
Date drilling completed: $8-03-04$)961-5210 54-6938 (fax)	E-log #:
· · · · · · · · · · · · · · · · · · ·			D 105 ".
State Law requires that this re		e driller in detail and filed w	vith the Department wit
30 days of completion of drillin Well Owner Inform		Wel	Location
• -		Latitude: $30 \circ 49 \cdot 948$	· · · · · · · · · · · · · · · · · · ·
Owner Name Teresa Smith 04026		Latitude: <u>30°99</u> , <u>998</u>	[™] Longitude: <u>४४°≪7</u> [™]
Mailing Address: Teresa Smith		Method of Lat/Long (circle of	ne): Conventional Survey,
,		USGS quad Hand-held	GPS Survey-grade GPS
1823 Parcely Avenue Pascagoula MS 39567 City State ZipCode			
		5E 1/ NE 1/ Sec 34	
		Distance Direction 7.5 Miles 55	Nearest Town
Telephone No. (60) 947-43	10	7.5 Miles 55	of hucedale
	· · · · · · · · · · · · · · · · · · ·		
	Well	Data	
Purpose of Well (circle one Home In	dustrial Public Supply	Irrigation Fish Culture	Other:
T appose of well (chele one fiome in	idusula i uone supply	Inigation Fish Culture	
		-	
Date well drilling started: 7-30 -	04 Date	well drilling completed: 8-	03-04
	04 Date	well drilling completed: 8-	03-04
Date well drilling started: $7-30$ - If flowing, method of flow regulation: V	O 4 Date alve Other (or	well drilling completed: 8-	03-04
Date well drilling started: $7-30$ - If flowing, method of flow regulation: V Static Water Level: 53 feet a	O 4 Date alve Other (alve above or below (circle one))	well drilling completed: 8- lescribe) land surface Date measured:	03-04 8-03-04
Date well drilling started: $7-30$ - If flowing, method of flow regulation: V Static Water Level: 53 feet a Method of Measurement (circle one)	O 4 Date alve Other (a above or below (circle one) steel tape electric tape	well drilling completed: lescribe) land surface Date measured: air line other:	03-04 8-03-04
Date well drilling started: $7-30$ - If flowing, method of flow regulation: V Static Water Level: 53 feet a Method of Measurement (circle one)	O 4 Date alve Other (a above or below (circle one) steel tape electric tape	well drilling completed: lescribe) land surface Date measured: air line other:	03-04 8-03-04
Date well drilling started: 7-30 - If flowing, method of flow regulation: V Static Water Level: 53 feet a Method of Measurement (circle one) Hole depth: 385 Well d	O 4 Date alve Other (or above or below (circle one)) steel tape electric tape	well drilling completed: lescribe) land surface Date measured: air line other:	03-04 8-03-04
Date well drilling started: 7-30 - If flowing, method of flow regulation: V Static Water Level: 53 feet a Method of Measurement (circle one) Hole depth: 385 Well d Type of grout (circle one): Cement	O 4 Date ialve Other (or above or below (circle one) steel tape epth: 385 Bentonite	well drilling completed: describe) land surface Date measured: air line other: Well grouted to a depth of	03-04 8-03-04 18 feet
Date well drilling started: 7-30 - If flowing, method of flow regulation: V Static Water Level: 53 feet a Method of Measurement (circle one) Hole depth: 385 Well d Type of grout (circle one): Cement Casing length: 375 feet Cas	O 4 Date of alve ialve Other (of above or below (circle one)) steel tape electric tape epth: 385 Bentonite Mix sing diameter: 2	well drilling completed: describe) land surface Date measured: air line other: Well grouted to a depth of 	03~04 8-03-04 18 feet 2" PJC 540
Date well drilling started: 7-30 - If flowing, method of flow regulation: V Static Water Level: 53 feet a Method of Measurement (circle one) Hole depth: 385 Well d Type of grout (circle one): Cement Casing length: 375 feet Cas Screen length: 10 feet Scr	O4 Date of all	well drilling completed: describe) land surface Date measured: air line other: Well grouted to a depth of 	03-04 8-03-04 18 feet 2" PUC 540 30P PUC 540
Date well drilling started: 7-30 - If flowing, method of flow regulation: V Static Water Level: 53 feet a Method of Measurement (circle one) Hole depth: 385 Well d Type of grout (circle one): Cement Casing length: 375 feet Cas	O4 Date of all	well drilling completed: describe) land surface Date measured: air line other: Well grouted to a depth of 	03-04 8-03-04 18 feet 2" PUC 540 30P PUC 540
Date well drilling started: 7-30 - If flowing, method of flow regulation: V Static Water Level: 53 feet a Method of Measurement (circle one) Hole depth: 385 Well d Type of grout (circle one): Cement Casing length: 375 feet Cas Screen length: 10 feet Scr Screen slot size: ,006 inches	O 4 Date of all of	well drilling completed: describe) land surface Date measured: air line other: Well grouted to a depth of well grouted to a depth of 	03-04 8-03-04 18 feet 2" PJL 540 JOP PJL 540 85 feet
Date well drilling started: 7-30 - If flowing, method of flow regulation: V Static Water Level: 53 feet a Method of Measurement (circle one) Hole depth: 385 Well d Type of grout (circle one): Cement Casing length: 375 feet Cas Screen length: 10 feet Scr Screen slot size: ,006 inches	O 4 Date of all of	well drilling completed: describe) land surface Date measured: air line other: Well grouted to a depth of inches Type of casing: inches Type of screen: feet to arreamed Telescoped Open	03-04 8-03-04 18 feet 2" PJC 540 SOP PJC 540 85 feet hole Natural Development
Date well drilling started: 7-30 - If flowing, method of flow regulation: V Static Water Level: 53 feet a Method of Measurement (circle one) Hole depth: 385 Well d Type of grout (circle one): Cement Casing length: 375 feet Cas Screen length: 10 feet Scr	O 4 Date of all of	well drilling completed: describe) land surface Date measured: air line other: Well grouted to a depth of well grouted to a depth of 	03-04 8-03-04 18 feet 2" PJC 540 SOP PJC 540 85 feet hole Natural Development
Date well drilling started: 7-30 - If flowing, method of flow regulation: V Static Water Level: 53 feet a Method of Measurement (circle one) Hole depth: 385 Well d Type of grout (circle one): Cement Casing length: 375 feet Cas Screen length: 10 feet Scr Screen slot size: ,006 inches	O 4 Date ialve Other (data above or below (circle one) Steel tape steel tape electric tape epth: 385 Bentonite Mix sing diameter: 2 Setting depth: From Setting depth: From (cravel packed) Under Other (describe):	well drilling completed: describe) land surface Date measured: air line other: Well grouted to a depth of 	03-04 8-03-04 18 feet 2" PJC 540 SOP PJC 540 85 feet hole Natural Development
Date well drilling started: 7-30 - If flowing, method of flow regulation: V Static Water Level: 53 feet a Method of Measurement (circle one) Hole depth: 385 Well d Type of grout (circle one): Cement Casing length: 375 feet Cas Screen length: 10 feet Scr Screen slot size: 1006 inches Type of completion (circle all applicable) Top of lap pipe or reduction in casing:	O 4 Date of alwe ialve Other (data alwe or below (circle one)) steel tape electric tape epth: 385 Bentonite Mix sing diameter: 2 Setting depth: From Setting depth: From Other (describe):	well drilling completed: describe) land surface Date measured: air line other: Well grouted to a depth of well grouted to a depth of well grouted to a depth of to a depth of inches Type of casing: feet to 3.7.5 feet to reamed Telescoped Open descoped or more than one screen	03-04 8-03-04 18 feet 2" PJC 540 SOP PJC 540 85 feet hole Natural Development cen, describe on back of pa
Date well drilling started: 7-30 - If flowing, method of flow regulation: V Static Water Level: 53 feet a Method of Measurement (circle one) Hole depth: 38.5 Well d Type of grout (circle one): Cement Casing length: 375 feet Cas Screen length: 10 feet Scr Screen slot size: ,006 inches Type of completion (circle all applicable) Top of lap pipe or reduction in casing:	O4 Date ialve Other (data above or below (circle one) Steel tape steel tape electric tape epth: 385 Bentonite Mix sing diameter: 2 Setting depth: From Setting depth: From Cravel packed Under Other (describe):	well drilling completed: describe) land surface Date measured: air line other: Well grouted to a depth of well grouted to a depth of well grouted to a depth of to a depth of inches Type of casing: feet to 3.7.5 feet to reamed Telescoped Open descoped or more than one screen	03-04 8-03-04 18 feet 2" PJC 540 SOP PJC 540 85 feet hole Natural Development seen, describe on back of pa
Date well drilling started:	O 4 Date ialve Other (construction of the construction of t	well drilling completed: describe) land surface Date measured: air line other: Well grouted to a depth of Well grouted to a depth of Well grouted to a depth of inches Type of casing: feet to 3.7.5 feet to Telescoped Open descoped or more than one screet Density Sonic Neutron (03.04 8-03-04 18 feet 2" PUC 540 SOP PUC 540 85 feet hole Natural Development cen, describe on back of pa
Date well drilling started:	O 4 Date of all of	well drilling completed: describe) land surface Date measured: arr line other: Well grouted to a depth of Well grouted to a depth of inches Type of casing: feet to 3.7.5 feet to arreamed Telescoped Open lescoped or more than one scree Density Sonic Neutron of accordance with all applicable	03-04 8-03-04 18 feet 18 feet 2" PJC 540 30P PJC 540 85 feet hole Natural Developments cen, describe on back of pa Other: requirements of the Missis
Date well drilling started:	O 4 Date of all of	well drilling completed: describe) land surface Date measured: arr line other: Well grouted to a depth of Well grouted to a depth of inches Type of casing: feet to 3.7.5 feet to arreamed Telescoped Open lescoped or more than one scree Density Sonic Neutron of accordance with all applicable	03-04 8-03-04 18 feet 18 feet 2" PJC 540 30P PJC 540 85 feet hole Natural Developments cen, describe on back of pa Other: requirements of the Missis
Date well drilling started: 7-30 - If flowing, method of flow regulation: V Static Water Level: 53 feet a Method of Measurement (circle one) Hole depth: 38.5 Well d Type of grout (circle one): Cement Casing length: 375 feet Cas Screen length: 10 feet Scr Screen slot size: 1006 inches Type of completion (circle all applicable) Top of lap pipe or reduction in casing: 100 feet Logs run (circle all applicable): 100 feet Name of organization running log(s): I certify that the well was drilled, const Department of Environmental Quality	O 4 Date of alve alve Other (classing diameter: Other (classing diameter: Bentonite Mix sing diameter: Q Setting depth: From Setting depth: From Other (describe): feet. If televel Date of the Mississippi Dependence If televel Tructed, and completed in a and/or the Mississippi Dependence If televel	well drilling completed: describe) land surface Date measured: air line other: Well grouted to a depth of Well grouted to a depth of inches Type of casing: feet to 3.7.5 feet to areamed Telescoped Open descoped or more than one scree Density Sonic Neutron of accordance with all applicable partment of Health regulations	03-04 8-03-04 18 feet 18 feet 2" PJC 540 30P PJC 540 85 feet hole Natural Developments cen, describe on back of pa Other: requirements of the Missis
Date well drilling started:	O 4 Date of alve alve Other (classified tape	well drilling completed: describe) land surface Date measured: arr line other: Well grouted to a depth of Well grouted to a depth of inches Type of casing: feet to 3.7.5 feet to arreamed Telescoped Open descoped or more than one scree Density Sonic Neutron of accordance with all applicable partment of Health regulations 	03-04 8-03-04 18 feet 18 feet 2° PJC 540 SOP PJC 540 85 feet hole Natural Development cen, describe on back of pa Other: requirements of the Missis

BY: OLWR


If well telescopes please sketch below and show depths.

Ground Level

H-75

Description of Formations Encountered	From	То
Topsand	0	12
Clay - yellow	12	27
Chu - blue	27	89
Silt - Blue	189	103
Clay - blue	A103	165
Silt Blue	165	175
Sand, fine	175	190
Clay - blyc	190	285
Sand - med	285	291
Clay-Blue	291	320
Sand - med	320	323
Class - Blue	323	<u>H8</u>
Sand - med	348	352
Clay - Blue	352	365
Sand - med	365	385
		L
		
		ļ
······································		
		L

If more than one screen, show location of each on sketch

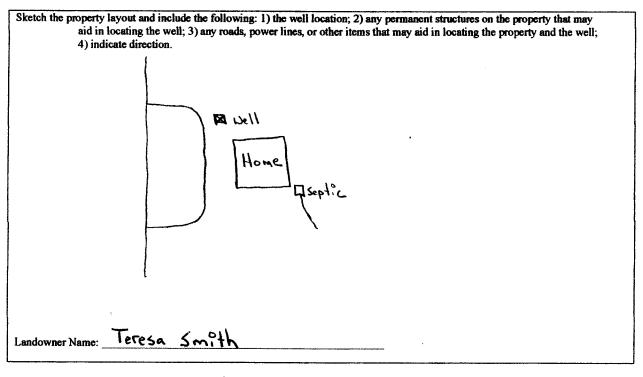

Signature of Water Well Contractor

RECEIVED AUG 2 0 2004 BY: OLWR

· STATE W	ELL REPORT		
County: George Pump Installer Permit #: Mississippi Departme Office of Land Driller: Michael S. Havard Jackson, Date completed: 8-03-04 (601)3	Part 2 For Office Use Only: r's Completion Report Aquifer: ent of Environmental Quality Aquifer: and Water Resources Well #: . Box 10631 Well #: MS 39289-0631 Elevation: 1961-5210 Elevation:		
This report should be prepared by the pump installer in de installation of pump.			
Well Owner Information	Well Location		
Owner Name: Teresa Smith	Latitude: 30° 49.948 N Longitude: 88° 27.919 W		
Mailing Address: Tercsa Smith	Method of Lat/Long (circle one): Conventional Survey,		
1823 Parcely Avenue	USGS quad, Hand-held GPS Survey-grade GPS		
Pascagoula MS 39567 City State Zip Code	1/4 1/4 Sec_34 Twn_T25 Rng R5W Distance Direction Nearest Town		
Telephone No. (401) 147 - 4310	7.5 Miles SE of Lucedale		
Pump Type Circle one	. Power Type Circle one		
Air Lift Jet Submersible	Diesel Engine Gasoline Engine Natural Gas		
Bucket Piston Turbine	Electric Motor Hand Tractor PTO		
Centrifugal Rotary Flowing Well	Windmill Other (specify):		
Other (specify):	Horse Power Rating of Motor:		
Date Pump Installed: 8-02-04	Setting Depth:feet		
Rated Pump Capacity: 10 Gallons Per Minute	Number of Stages:		
Pump Test Data Date Well Tested: 7-31-04	Method of Measuring Water Level Circle one		
Static Water Level (A): <u>53</u> Feet Below Land Surface Pumping Water Level (B): <u>85</u> Feet Below Land Surface	Air Line Electric Measuring Line Steel Tape Other (specify):		
Drawdown [(B) – (A)]: <u>35</u> Feet Below Land Surface	For flowing well, measured shut in head:feet		
Test Pumping Rate: 35 Gallons Per Minute	Well yielded GPM with a drawdown of		
Duration of Pump Test (minimum 4 hours): hours	<u>35</u> feet after <u>4</u> hours of pumping		
I HEREBY CERTIFY that the above statements are true to the bes Michael S. Havaed Print Name of Pump Installer and License No. (if applicable)	st of my knowledge. Signature of Pump Installer BECEIVER		

٢,

۰.

AUG 2 0 2004 BY: OLW R