
| 120.00 | State Well Report | |
|---|--|---|
| County: Deorge | Part 1 – Driller's Log | For Office Use Only: |
| Permit #: 0 - 780 | Mississippi Department of Environmental Quality | Aquifer: |
| 2 | Office of Land and Water Resources | 11 1011 |
| Driller: W. Joel Presc | P.O. Box 10631 | Well #: <u>H-104</u> |
| Date drilling completed: 1-2-67 | Jackson, MS 39289-0631 | L. S. Elevation: |
| Date drifting completed: _/ | () | |
| | (601)354-6938 (fax) | E-log #: |
| State Law requires that this repu | ort be prepared by the license holder responsible for t | the work and filed with the |
| Information on Well | ss within 30 days of completion of drilling of the well | or borehole. |
| (Landowner if borehole is not | for a water well | rehole Location |
| | 1 | " Longitude: 30 . 50 . 0/2 |
| Owner Name_JULU_DU | Latitude | 01 |
| Mailing Address: 1102 Acre | Latonia Rd Method of Lat/Long (circle or | ne): Conventional Survey, |
| , | | GPS, Survey-grade GPS |
| | 39412 MAS 1/ SE 1/ San 33 | Twn JS Rng SW |
| Lucecale m | STIDE SW NE | |
| City St | tate Zip Code Distance Direction | Nearest Town |
| Telephone No. (601) 947-34 | $\frac{3}{\text{Miles}} \frac{\pi E}{\pi E}$ | of Aquilly us |
| | | |
| | Well / Borehole Data | |
| Date drilling started: 1-2-07 Date of | trilling completed: 1-2-07 Hole depth: 55 | Hole diameter 2 |
| | | |
| Location of the source of any surface wa | ter used for drilling: <u>Aquilan</u> w | |
| Method of dosing and volume of Chlori | ne used in drilling and development: | 1 Zow Waly |
| Logs run (circle all applicable): No log r | Electric Gamma Ray Density Sonic Neutron | Other |
| Name of organization running log(s): | | Ould1. |
| Purpose of horehole (check and): Water I | | |
| apose of borenoic (eneck one). Water | WellGeotechnical/Geological Investigation Ground | Source Heat Pump |
| Seismic | Survey Other (describe) | |
| If drilling is not relate | ed to water well construction, skip the remainder of this blo | ock |
| Purpose of Well (check one): Home | Industrial Public Supply Irrigation Fish Culture | Other |
| | | |
| f a flowing well method of flow regulati | ion: Valve Other (describe) | |
| a non alg non, moulod of now regular | | |
| | bove or below (ercle one) land surface Date measured: | |
| Static Water Level: <u>3</u> feet a | above or below (orcle one) land surface Date measured: | 1-2-07 |
| Static Water Level: <u>3</u> feet a Method of Measurement (circle one) | steel tape electric tape air line other: | 1-2-07 |
| Static Water Level: <u>3</u> feet a Method of Measurement (circle one) well depth: <u>55</u> Well grouted to a d | steel tape electric tape air line other: | 1-2-07 ent Bentonite Mix |
| Static Water Level: <u>3</u> feet a Method of Measurement (circle one) $\frac{3}{2}$ Well depth: <u>55</u> Well grouted to a d Casing length: <u>45</u> feet Cas | steel tape electric tape air line other: lepth of <u>10</u> feet Type of grout (circle one): Neat Cemu ing diameter: <u>2</u> inches Type of casing: | 1-2-07 ent Frentonite Mix Sch 40 Plastic |
| Static Water Level: <u>3</u> feet a Method of Measurement (circle one) $\frac{3}{2}$ Well depth: <u>55</u> Well grouted to a d Casing length: <u>45</u> feet Cas | steel tape electric tape air line other: | 1-2-07 ent Frentonite Mix Sch 40 Plastic |
| Static Water Level: <u>3</u> feet a Method of Measurement (circle one) well depth: <u>55</u> Well grouted to a d Casing length: <u>45</u> feet Cas Screen length: <u>10</u> feet Scr | steel tape electric tape air line other: lepth of <u>10</u> feet Type of grout (circle one): Neat Cern ing diameter: <u>2</u> inches Type of casing: een diameter: <u>2</u> inches Type of screen: | 1-2-07 ent Frentonite Mix Sch 40 Plastic Sh 80 (1 |
| Static Water Level: <u>3</u> feet a Method of Measurement (circle one) Well depth: <u>55</u> Well grouted to a d Casing length: <u>45</u> feet Cas Screen length: <u>10</u> feet Scr Screen slot size: <u>6</u> inches | steel tape electric tape air line other: tepth of <u>10</u> feet Type of grout (circle one): Neat Cemu ing diameter: <u>2</u> inches Type of casing: een diameter: <u>2</u> inches Type of screen: Setting depth: From <u>0</u> feet to <u>5</u> <u>10 Source</u> <u>45 Con</u> | 1-2-07 ent Bentonite Mix Sch 40 Plastei Sh Bo (1 5 feet |
| Static Water Level: <u>3</u> feet a Method of Measurement (circle one) Well depth: <u>55</u> Well grouted to a d Casing length: <u>45</u> feet Cas Screen length: <u>10</u> feet Scr Screen slot size: <u>6</u> inches | steel tape electric tape air line other: tepth of <u>10</u> feet Type of grout (circle one): Neat Cemu ing diameter: <u>2</u> inches Type of casing: een diameter: <u>2</u> inches Type of screen: Setting depth: From <u>0</u> feet to <u>5</u> <u>10 Source</u> <u>45 Con</u> | 1-2-07 ent Frentonite Mix Sch 40 Plastic Sh 80 (1 |
| Static Water Level: <u>3</u> feet a Method of Measurement (circle one) well depth: <u>55</u> Well grouted to a d Casing length: <u>45</u> feet Cas Screen length: <u>10</u> feet Scr | steel tape electric tape air line other: tepth of <u>10</u> feet Type of grout (circle one): Neat Cemu ing diameter: <u>2</u> inches Type of casing: een diameter: <u>2</u> inches Type of screen: Setting depth: From <u>0</u> feet to <u>5</u> <u>10 Source</u> <u>45 Con</u> | 1-2-07 ent Bentonite Mix Sch 40 Plastei Sh 80 (1 5 feet name hole Natural Development |
| Static Water Level: <u>3</u> feet a Method of Measurement (circle one) Well depth: <u>55</u> Well grouted to a d Casing length: <u>45</u> feet Cas Screen length: <u>10</u> feet Scr Screen slot size: <u>6</u> inches Type of completion (circle all applicable) | steel tape electric tape air line other: tepth of <u>10</u> feet Type of grout (circle one): Neat Cemu ing diameter: <u>2</u> inches Type of casing: een diameter: <u>2</u> inches Type of screen: Setting depth: From <u>0</u> feet to <u>5</u> <u>10 Soccean</u> <u>45 coc</u> Gravel packed Underreamed Telescoped Open | 1-2-07 ent Frentonite Mix Sch 40 Plastic Sh 80 (1 5 feet nains hole Natural Development |

BY: OLWR

6

H. 104

The sketch below only required for water wells

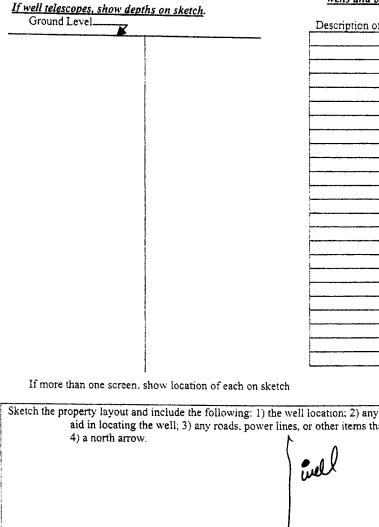

Description of formations encountered must be provided for all wells and boreholes, unless specifically exempted by regulations

| Description of Formations Encountered | From (depth) | To (depth) |
|---------------------------------------|--------------|------------|
| | Ground Level | 1 |
| | 1 | |
| Red Sand | 0 | 5 |
| | | |
| Net clay | 5 | 15 |
| white same | 1 | |
| Culite Same | 15 | 55 |
| ***** | | |
| | | |
| | | |
| | | + |
| | | 1 |
| | | |

Sketch the property layout and include the following: 1) the well location; 2) any permanent structures on the property that may aid in locating the well; 3) any roads, power lines, or other items that may aid in locating the property and the well; East, Hw Y 612 Aglicola Catorica Rd Landowner Name: Form: OLWR-SWR-1A I certify that the well/borehole was drilled, constructed, and completed in accordance with all applicable requirements of the Mississippi Department of Environmental Quality and the Mississippi Department of Health regulations, if applicable, and state laws. -7-0 w

Print Name of Responsible Licensee and License No.

Signature of Licensee

| | STATE WELL REPORT | |
|---------------------------------------|---|-----------------------------|
| County: Deorge | Part 2 | For Office Use Only: |
| Permit #: $0 - 780$ | Pump Installer's Completion Report Mississippi Department of Environmental Quality | Aquifer: |
| Driller. W. Jcel Pierce | Office of Land and Water Resources P.O. Box 10631 | |
| Date completed: 1-2-07 | Jackson, MS 39289-0631 | Well #: <u><u>H-104</u></u> |
| Copy information from block on Part 1 | (601)961-5210 (601)354-6938 (fax) | Elevation: |

-

DEDODE

This part of the report must be completed by a licensed water well contractor or a licensed pump installer. A copy of Part 1 of the report must be attached and both parts filed with the Department at the above address within 30 days of well completion.

Well Location Well Owner Information Latitude: 88-29-259 Longitude: 30 50 012 Owner Name: Cotour 12 Method of Lat/Long (check one): Conventional Survey____, Me Mailing Address: USGS quad_____, Hand-held GPS____, Survey-grade GPS__ <u>3445</u> Zip Code NW 1/4 5E 1/4 Sec 33 T 75 R 5W ws State Direction Ncarcst Town Distance 3 Miles ME of Aquala, un Telephone No. (60/) 847 - 34/1

| | Pump Typ Circle one | | | Power Type Circle one | |
|------------------------|------------------------|--------------------|--------------------|--------------------------|-------------|
| Air Lift | Jet | Submersible | Diesel Engine | Gasoline Engine | Natural Gas |
| Bucket | Piston | Turbine | Electric Motor | Hand | Tractor PTO |
| Centrifugal | Rotary | Flowing Well | Windmill | Other (specify): | |
| Other (specify): | | | Horse Power Rating | g of Motor: | |
| Date Pump Installed: _ | 1-2- | -07 | Setting Depth: | 25 fet line | feet |
| Rated Pump Capacity: | 10 | Gallons Per Minute | Number of Stages: | 2 | |

| Pump Test Data | Method of Measuring Water Level Circle one | | |
|--|--|--|--|
| Date Well Tested: $1 - 2 - 0$? Static Water Level (A): 3 Feet Below Land Surface Pumping Water Level (B): 35 Feet Below Land Surface Drawdown [(B) - (A)]: 2 Feet Below Land Surface | Air Line Electric Measuring Line Steel Tape Other (specify): | | |
| Test Pumping Rate: <u>ID</u> Gallons Per Minute Duration of Pump Test (minimum 4 hours): <u>48</u> hours | Well yielded <u>(O</u> GPM with a drawdown of <u>2</u> feet after <u>48</u> hours of pumping | | |
| I HEREBY CERTIFY that the above statements are true to the best Soel ULL 0-780 Print Name of Pump Installer and License No. (if applicable) | of my knowledge. | | |

Form: OLWR-SWR-1B