

State Well Report

Part 1 - Driller's Log

Mississippi Department of Environmental Quality
Office of Land and Water Resources
P.O. Box 2309
Jackson, MS 39225
(601)961- 5210
(601)961- 5228 (fax)

County: George
Permit #: 0-780
Driller: J. Pierce
Date drilling completed: 1-22-14

For Office Use Only:
Aquifer: _____
Well #: H145
L. S. Elevation: _____
E-log #: _____

State Law requires that this report be prepared by the license holder responsible for the work and filed with the Department at the above address within 30 days of completion of drilling of the well or borehole.

Information on Well Owner (Landowner if borehole is not for a water well)	Well or Borehole Location
Owner Name: <u>Robert Roberson</u>	Latitude: <u>30° 49' 36"</u> Longitude: <u>88° 29' 22"</u>
Mailing Address: <u>2160 Hwy 612</u>	Method of Lat/Long (circle one): Conventional Survey, _____
<u>Lucedale MS 39452</u>	USGS quad, Hand-held GPS, Survey-grade GPS <input checked="" type="checkbox"/>
City State Zip Code	<u>SW 1/4 SE 1/4 Sec 33 Twn 25 Rng 5W</u>
Telephone No. <u>(228) 623-6969</u>	Distance <u>3</u> Miles <u>East</u> of <u>Aquala, MS</u>

Well / Borehole Data

Date drilling started: 1-22 Date drilling completed: 1-22 Hole depth: 65 Hole diameter: 2

Location of the source of any surface water used for drilling: Aquala, MS

Method of dosing and volume of Chlorine used in drilling and development: 4 gal Bleach 2000 water

Logs run (circle all applicable): No log run Electric Gamma Ray Density Sonic Neutron Other: _____

Name of organization running log(s): _____

Purpose of borehole (check one): Water Well Geotechnical/Geological Investigation Ground Source Heat Pump

Seismic Survey Other (describe) _____

If drilling is not related to water well construction, skip the remainder of this block

Purpose of Well (check one): Home Industrial Public Supply Irrigation Fish Culture Other: _____

If a flowing well, method of flow regulation: Valve _____ Other (describe) _____

Static Water Level: 5 feet above or below (circle one) land surface Date measured: 1-22-14

Method of Measurement (circle one) steel tape electric tape air line other: _____

Well depth: 65 Well grouted to a depth of 10 feet Type of grout (circle one): Neat Cement Bentonite Mix

Casing length: 55 feet Casing diameter: 2 inches Type of casing: sch 40 Plastic

Screen length: 10 feet Screen diameter: 2 inches Type of screen: sch 40 Plastic

Screen slot size: 10 inches Setting depth: From 55 feet to 65 feet

Type of completion (circle all applicable): Gravel packed Underreamed Telescoped Open hole Natural Development

Other (describe): _____

Top of lap pipe or reduction in casing: _____ feet. *If telescoped or more than one screen, describe on next page*


Form: OLWR-SW-1 (06/09)
RECEIVED
BY: OLWR

1145

The sketch below only required for water wells


Description of formations encountered must be provided for all wells and boreholes, unless specifically exempted by regulations

If well telescopes, show depths on sketch.

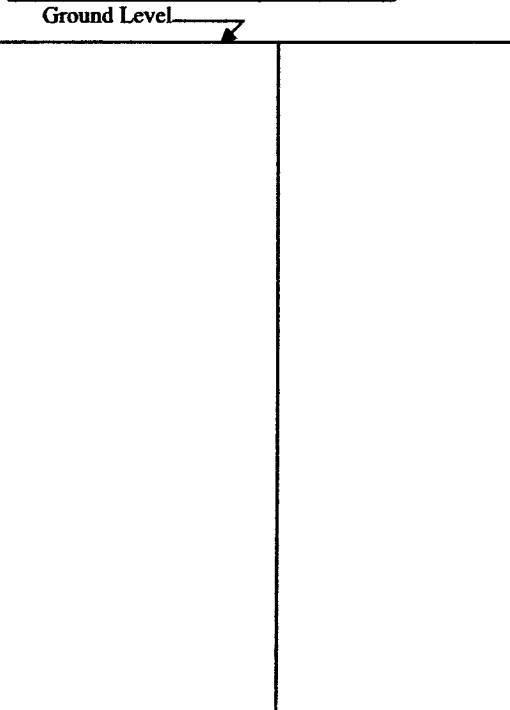

Description of Formations Encountered	From (depth) To (depth)	
	Ground Level	
sand	0	65

If more than one screen, show location of each on sketch

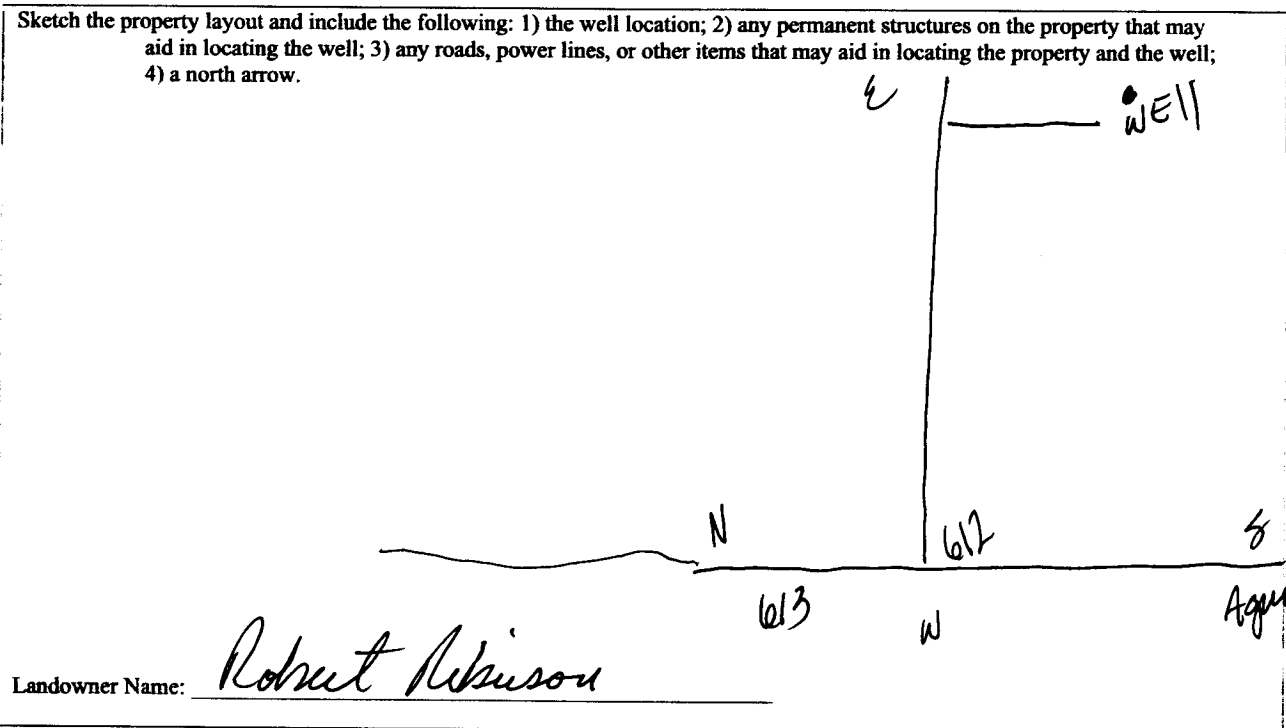

Form: OLWR-SWR-1A (04/08)

I certify that the well/borehole was drilled, constructed, and completed in accordance with all applicable requirements of the Mississippi Department of Environmental Quality and the Mississippi Department of Health regulations, if applicable, and state laws.

Print Name of Responsible Licensee and License No. Joel Pene 0-780

Date 1-22-14

Signature of Licensee Joel Pene

RECEIVED
BY: OLWR

STATE WELL REPORT

Part 2

Pump Installer's Completion Report
 Mississippi Department of Environmental Quality
 Office of Land and Water Resources
 P.O. Box 2309
 Jackson, MS 39225
 (601)961-5210
 (601)961-5228 (fax)

For Office Use Only:

Aquifer: _____

Well #: 1145

Elevation: _____

County: Blount
 Permit #: 0-780
 Driller: J-Piehl
 Date completed: 1-22-14
Copy information from block on Part 1

This part of the report must be completed by a licensed water well contractor or a licensed pump installer. A copy of Part 1 of the report must be attached and both parts filed with the Department at the above address within 30 days of well completion.

Well Owner Information	Well Location
Owner Name: <u>Robert Robertson</u>	Latitude: <u>30-48-36</u> Longitude: <u>88-29-27</u>
Mailing Address: <u>2160 Hwy 612</u>	Method of Lat/Long (check one): Conventional Survey _____
<u>Lucedah</u> <u>MS</u> <u>39452</u>	USGS quad _____, Hand-held GPS <input checked="" type="checkbox"/> , Survey-grade GPS _____
City State Zip Code	<u>SW</u> $\frac{1}{4}$ <u>SE</u> $\frac{1}{4}$ Sec <u>33</u> T <u>25</u> R <u>5W</u>
Telephone No. <u>(228) 623-6969</u>	Distance _____ Miles Direction <u>east</u> of Nearest Town <u>Aquila, MS</u>

Pump Type	Power Type
Circle one	Circle one
Air Lift <input type="checkbox"/> Jet <input checked="" type="checkbox"/> Submersible	Diesel Engine Gasoline Engine Natural Gas
Bucket Piston Turbine	<input checked="" type="checkbox"/> Electric Motor Hand Tractor PTO
Centrifugal Rotary Flowing Well	Windmill Other (specify): _____
Other (specify): _____	Horse Power Rating of Motor: <u>1</u>
Date Pump Installed: <u>1-22-14</u>	Setting Depth: <u>35 jet line</u> feet
Rated Pump Capacity: <u>10</u> Gallons Per Minute	Number of Stages: <u>2</u>

Pump Test Data	Method of Measuring Water Level
	Circle one
Date Well Tested: <u>1-22-14</u>	<input checked="" type="checkbox"/> Air Line Electric Measuring Line Steel Tape
Static Water Level (A): <u>5</u> Feet Below Land Surface	Other (specify): _____
Pumping Water Level (B): <u>30</u> Feet Below Land Surface	For flowing well, measured shut in head: _____ feet
Drawdown [(B) - (A)]: <u>2</u> Feet Below Land Surface	Well yielded <u>10</u> GPM with a drawdown of
Test Pumping Rate: <u>10</u> Gallons Per Minute	<u>2</u> feet after <u>48</u> hours of pumping
Duration of Pump Test (minimum 4 hours): <u>48</u> hours	

This is for (circle one): **New Well** Replacement of Existing Pump Repair of Existing Pump

RECEIVED

I HEREBY CERTIFY that the above statements are true to the best of my knowledge.

Joel Piehl 0-780
 Print Name of Pump Installer and License No. (if applicable)

Joel Piehl
 Signature of Pump Installer



Map of:
George County, MS

Notes

HIAS

Empty text box for notes.

mapquest  **FREE NAVIGATION APP**
 SELECT: IPHONE ANDROID
 Enter your mobile number
 Message and data rates may apply, text STOP to end, HELP for assistance. **SEND ME THE LINK**



©2014 MapQuest, Inc. Use of directions and maps is subject to the MapQuest Terms of Use. We make no guarantee of the accuracy of their content, road conditions or route usability. You assume all risk of use. [View Terms of Use](#)

RECEIVED
 FEB 10 2014
 BY: OLWR