

State Well Report

Part 1 - Driller's Log

Mississippi Department of Environmental Quality
Office of Land and Water Resources
P.O. Box 2309
Jackson, MS 39225
(601)961- 5210
(601)961- 5228 (fax)

For Office Use Only:

Aquifer: _____
Well #: H 147
L. S. Elevation: _____
E-log #: _____

County: DeWitt
Permit #: 0-780
Driller: J. Paul
Date drilling completed: 3-14-14

State Law requires that this report be prepared by the license holder responsible for the work and filed with the Department at the above address within 30 days of completion of drilling of the well or borehole.

Information on Well Owner (Landowner if borehole is not for a water well)	Well or Borehole Location
Owner Name: <u>Pierce Farms</u>	Latitude: <u>30° 50' 22"</u> Longitude: <u>88° 24' 51"</u> <u>30° 49' 58.79"</u> <u>88° 24' 52.8"</u>
Mailing Address: <u>Aquila Caloua Rd</u>	Method of Lat/Long (circle one): Conventional Survey,
<u>Medale</u> MS <u>39452</u>	USGS quad: <u>Hand-held GPS</u> Survey-grade GPS
City State Zip Code	<u>NE 1/4 SE 1/4 Sec 32</u> Twn <u>25</u> Rng <u>5W</u>
Telephone No. ()	Distance <u>3</u> Miles Direction <u>NE</u> of Nearest Town <u>Aquila, MS</u>

Well / Borehole Data

Date drilling started: 3-14 Date drilling completed: 3-14 Hole depth: 230 Hole diameter: 4

Location of the source of any surface water used for drilling: Aquila, MS
Method of dosing and volume of Chlorine used in drilling and development: 2000 water 4gal chlorine

Logs run (circle all applicable): No log run Electric Gamma Ray Density Sonic Neutron Other: _____
Name of organization running log(s): _____

Purpose of borehole (check one): Water Well Geotechnical/Geological Investigation _____ Ground Source Heat Pump _____
Seismic Survey _____ Other (describe) _____

If drilling is not related to water well construction, skip the remainder of this block

Purpose of Well (check one): Home Industrial _____ Public Supply _____ Irrigation Fish Culture _____ Other: _____

If a flowing well, method of flow regulation: Valve _____ Other (describe) _____

Static Water Level: 8 feet above or below (circle one) land surface Date measured: 3-14-14

Method of Measurement (circle one) steel tape electric tape air line other: _____

Well depth: 230 Well grouted to a depth of 10 feet Type of grout (circle one): Neat Cement Bentonite Mix

Casing length: 200 feet Casing diameter: 4 inch inches Type of casing: Sch 40

Screen length: 30 feet Screen diameter: 4 inches Type of screen: Sch 40

Screen slot size: 10 inches Setting depth: From 0 feet to 230 feet

Type of completion (circle all applicable): Gravel packed Underreamed Telescoped Open hole Natural Development
Other (describe): _____

Top of lap pipe or reduction in casing: _____ feet. **If telescoped or more than one screen, describe on next page**

Form: OLWR-SWR-1A (04/08)

H147

The sketch below only required for water wells

If well telescopes, show depths on sketch.

Ground Level →

If more than one screen, show location of each on sketch

Description of formations encountered must be provided for all wells and boreholes, unless specifically exempted by regulations

Description of Formations Encountered	From (depth) To (depth)	
	Ground Level	
Red Sand	0	15
Yellow clay	15	20
Sand	20	85
Green clay	85	190
Grey sand	190	230

Sketch the property layout and include the following: 1) the well location; 2) any permanent structures on the property that may aid in locating the well; 3) any roads, power lines, or other items that may aid in locating the property and the well; 4) a north arrow.

Landowner Name: Paul Farns

Form: OLWR-SWR-1A (04/08)

I certify that the well/borehole was drilled, constructed, and completed in accordance with all applicable requirements of the Mississippi Department of Environmental Quality and the Mississippi Department of Health regulations, if applicable, and state laws.

Joel Peau 0780 3-14-14 Joel Pe

Print Name of Responsible Licensee and License No. Date Signature of Licensee

STATE WELL REPORT

Part 2

Pump Installer's Completion Report
 Mississippi Department of Environmental Quality
 Office of Land and Water Resources
 P.O. Box 2309
 Jackson, MS 39225
 (601)961-5210
 (601)961-5228 (fax)

For Office Use Only:

Aquifer: _____
 Well #: H147
 Elevation: _____

County: DeWitt
 Permit #: 0-780
 Driller: J. Pierre
 Date completed: 3-14-14
Copy information from block on Part 1

This part of the report must be completed by a licensed water well contractor or a licensed pump installer. A copy of Part 1 of the report must be attached and both parts filed with the Department at the above address within 30 days of well completion.

Well Owner Information	Well Location
Owner Name: <u>Pierre Fournis</u>	Latitude: <u>30-50-22</u> Longitude: <u>88-29-51</u> <small>30° 49' 58.79" 88° 29' 52.8"</small>
Mailing Address: <u>Agula Laban Rd</u>	Method of Lat/Long (check one): Conventional Survey _____
<u>Cumtola ms 39452</u> <small>City State Zip Code</small>	USGS quad _____, Hand-held GPS <input checked="" type="checkbox"/> , Survey-grade GPS _____
Telephone No. () _____	<u>NE</u> 1/4 <u>SE</u> 1/4 Sec <u>37</u> T <u>25</u> R <u>5W</u>
	Distance <u>3</u> Miles <u>NE</u> Direction of <u>Agula, MS</u> Nearest Town

Pump Type Circle one	Power Type Circle one
Air Lift <input type="checkbox"/> Jet <input type="checkbox"/> <u>Submersible</u>	Diesel Engine <input type="checkbox"/> Gasoline Engine <input type="checkbox"/> Natural Gas <input type="checkbox"/>
Bucket <input type="checkbox"/> Piston <input type="checkbox"/> Turbine <input type="checkbox"/>	<u>Electric Motor</u> <input type="checkbox"/> Hand <input type="checkbox"/> Tractor PTO <input type="checkbox"/>
Centrifugal <input type="checkbox"/> Rotary <input type="checkbox"/> Flowing Well <input type="checkbox"/>	Windmill <input type="checkbox"/> Other (specify): _____
Other (specify): _____	Horse Power Rating of Motor: <u>5hp pump</u>
Date Pump Installed: <u>3-14-14</u>	Setting Depth: <u>120 drop pipe</u> feet
Rated Pump Capacity: <u>100</u> Gallons Per Minute	Number of Stages: <u>15</u>

Pump Test Data	Method of Measuring Water Level Circle one
Date Well Tested: _____	<u>Air Line</u> <input type="checkbox"/> Electric Measuring Line <input type="checkbox"/> Steel Tape <input type="checkbox"/>
Static Water Level (A): <u>8</u> Feet Below Land Surface	Other (specify): _____
Pumping Water Level (B): <u>30</u> Feet Below Land Surface	For flowing well, measured shut in head: _____ feet
Drawdown [(B) - (A)]: <u>5</u> Feet Below Land Surface	Well yielded <u>100</u> GPM with a drawdown of
Test Pumping Rate: <u>100</u> Gallons Per Minute	<u>2</u> feet after <u>48</u> hours of pumping
Duration of Pump Test (minimum 4 hours): <u>48</u> hours	

This is for (circle one): New Well Replacement of Existing Pump Repair of Existing Pump

I HEREBY CERTIFY that the above statements are true to the best of my knowledge.
Joe Pierre 0-780 Joe Pierre
 Print Name of Pump Installer and License No. (if applicable) Signature of Pump Installer

24TimeZones.com

Detailed online map of Agricola, Mississippi
Satellite map - street map and area map

[Gestión anuncios](#) ▶ [Printable MAP](#) [Mapa de](#) [Satelite MAP](#) [Mapa Warszawa](#)

Online Map of Agricola - street map and satellite map


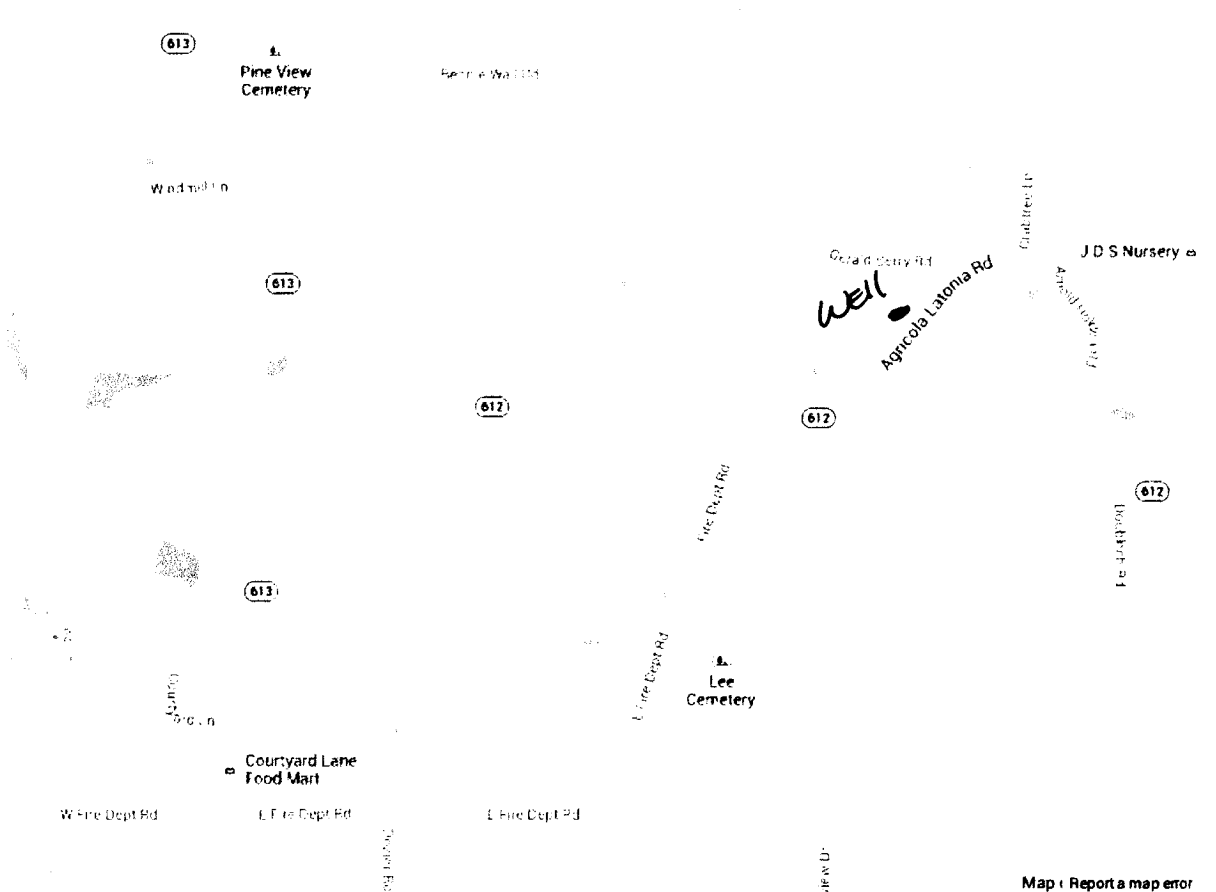
Agricola, George County, Mississippi on Googlemap

BOOKMARK

Satellite View
My House

onlinemapfinder.com

Search Maps, Get
Driving Directions
Instantly with Free App!

View Google Map for locations near Agricola : [Hurley, Wade, Big Point, Semmes](#)

HP Chromebook 11

google.com/chromebook

Everything you need in one laptop. Made with Google. Learn more.

58-498
30-833