

George
H 7023
7-5-81

MISSISSIPPI
BOARD OF WATER COMMISSIONERS
416 North State Street
Jackson, Mississippi 39201

WATER WELL DRILLERS LOG

7-5 1981 Pierce Drilling Co. George
date well completed firm name county well located


LANDOWNER: Elbert Stringer
Rt 2
Lucedale, Ms
(mailing address)

description of formations encountered	from to	
TOP Soil	0	10
Sand	10	20
clay + Sand	20	30
Good Sand	30	63

WELL LOCATION:
sec. 35 T. 2 N. R. 5 E
9 miles South E of Lucedale
(distance) (direction) (nearest town)

WELL PURPOSE:
 (Home) Irrigation, municipal, industrial

WELL COMPLETION DATA:
(1) diameter (inches) 2"
(2) total depth (feet) 63'
(3) static water level (feet) 30' below above top of ground.
(4) casing Plastic, 53'
(material) (depth)
0 If telescope see back.
(size)
(5) screen 10', 63'
(length) (depth to top)
010, Plastic
(size) (material)
(6) pump 1, 8
(HP) (yield gpm)
Electric
(type power)
(7) electric log (yes or no)
(organization running log)
(8) how well bottom plugged BW

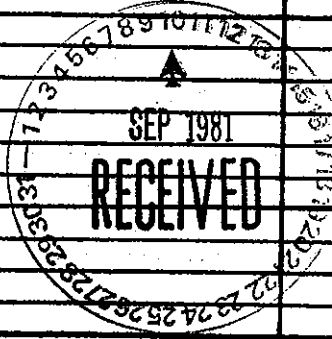

DRILLERS REMARKS: