

MISSISSIPPI DEPARTMENT OF ENVIRONMENTAL QUALITY

Office of Land and Water Resources

P. O. Box 10631

Jackson, MS 39289-0631

WATER WELL DRILLERS LOG

COUNTY WELL LOCATED <u>George</u>	
WELL NUMBER <u>H 2105</u>	CODED
DATE WELL COMPLETED <u>1-27-97</u>	

PERMIT NUMBER
NAME OF DRILLING FIRM <u>Purca Well</u>

NAME & MAILING ADDRESS OF LANDOWNER <u>Beverly Spivey</u> <u>Shepman Comm.</u> <u>Lucedale Ms</u>			
WELL LOCATION	SEC	TOWNSHIP	RANGE
	<u>10</u>	<u>2 N</u>	<u>5 E</u>
DISTANCE	DIRECTION	NEAREST TOWN	
<u>2 1/2</u> Miles	<u>SW</u> of	<u>Mound</u>	
OTHER LANDMARK			
WELL PURPOSE <input checked="" type="checkbox"/> Home, <input type="checkbox"/> Irrigation, <input type="checkbox"/> Municipal, <input type="checkbox"/> Industrial, <input type="checkbox"/> Fish Pond, etc.			

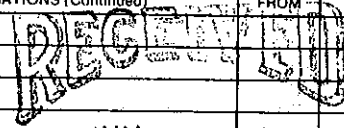
PUMP DATA		
PUMP TYPE (Circle One): Submersible, Turbine, <input checked="" type="radio"/> Jet, Flowing Well, Other (Describe) _____		
POWER TYPE (Circle One): <input checked="" type="radio"/> Electric, Tractor, Diesel, Gasoline, Butane, Other (Describe) _____ H/P <u>1</u>		
Pump Capacity (GPM)	No. of Stages	Setting Depth:
<u>10</u>	<u>2</u>	<u>60</u> FT.
PUMP TEST		
Well yielded <u>8</u> GPM with a drawdown of <u>10</u> ft. after <u>1</u> hours of pumping		

WELL DATA		
Well Depth	Casing Diameter (In.)	Casing Length (Ft.)
<u>70'</u>	<u>2"</u>	<u>60'</u>
Type of Casing	Hole Depth	Depth to Static Water Level
<u>Plastic</u>	<u>70'</u>	<u>40</u>
TYPE OF COMPLETION: (Circle One or More): <input type="checkbox"/> Gravel Packed, <input type="checkbox"/> Underreamed, <input type="checkbox"/> Telescoped, <input checked="" type="checkbox"/> Natural Development, <input type="checkbox"/> Open Hole, <input type="checkbox"/> Other (Describe) _____		
WELL GROUTED TO A DEPTH OF <u>15</u> FEET Type Grout (circle one): Cement, Bentonite, or Mix <input checked="" type="checkbox"/>		

LOG DATA	
TYPE OF LOG RUN (Circle One): <input checked="" type="radio"/> No Log Run, <input type="radio"/> Electric, <input type="radio"/> Gamma Ray, <input type="radio"/> Density, <input type="radio"/> Sonic, <input type="radio"/> Neutron, Other (Describe) _____	
Name of Organization Running Log	

SCREEN DATA		
Diameter - Inches	Length - Feet	Slot Size - Inches
<u>2"</u>	<u>10</u>	<u>006</u>
Screen Type	Depth to Bottom - Feet	
<u>Plastic</u>	<u>70'</u>	

GEOLOGIC DATA (Office Use Only)			
Surface Elev.	Geologic Unit	Unit Thickness	Depth to Top
Subs. SWL	Date	Analysis	Aquifer Test
Driller's Remarks			
Top of Lap Pipe or Reduction in Casing			
FEET <input type="checkbox"/> IF TELESCOPED OR MORE THAN ONE SCREEN: USE BACK PAGE			

DESCRIPTION OF FORMATIONS ENCOUNTERED	FROM	TO	FORMATIONS (Continued)	FROM	TO
<u>Top Soil</u>	<u>0</u>	<u>10</u>	 <u>JUN 05 1997</u> Dept. of Environmental Quality Office of Land & Water Resources		
<u>Clay</u>	<u>10</u>	<u>30</u>			
<u>Sand</u>	<u>30</u>	<u>40</u>			
<u>Good Sand</u>	<u>40</u>	<u>70</u>			

IF MORE SPACE IS NEEDED, USE BACK