

GEORGE MISSISSIPPI BOARD OF WATER COMMISSIONERS

J 20

6-30-60

WATER WELL DRILLERS LOG

CODED

Date: June 30, 1960, Driller: C. J. Switzer Walton County

(Name)

GEORGE

| (1) Owner of Land: | Description & Color of Materials Sand, Clay, Red Clay, Shell, etc. | Thick- ness Feet | Depth Feet |
|---|---|------------------------|---------------|
| | | | |
| <u>Clement Sautier</u> <small>(Name)</small> <u>Sautier's Hunting Camp on</u> <u>Red Creek</u> <small>(Address)</small> | <u>Red surface clay</u> | <u>3</u> | <u>3</u> |
| | <u>Blue shale</u> | <u>144</u> | <u>147</u> |
| (2) Location: <u>1/4</u> , <u>1/4</u> , Sec. <u>14</u> T. <u>35</u> R. <u>9W</u> | <u>sand (to fine to make well)</u> | <u>12</u> | <u>159</u> |
| <u>20</u> miles <u>N</u> , of <u>Biloxi</u> <small>(distance) (direction) (Nearest Town)</small> | <u>Blue shale</u> | <u>95</u> | <u>254</u> |
| (3) Topography: <input checked="" type="checkbox"/> <u>Hilly</u> <input type="checkbox"/> Flat <input type="checkbox"/> Level | <u>sand - coarse</u> | <u>33</u> | <u>287</u> |
| (4) Purpose of Well: <u>Domestic</u> <small>(Domestic Irrigation Municipal, Industrial, Other)</small> | | | |


Information upon completion of well:

- (1) Diameter 2 inches.
- (2) Total Depth 287 feet.
- (3) Water Level even with ground feet below top of ground.
- (4) Cased to 287' Size 2"
- (5) Screen: Size 0800, Length 10'
- (6) Were any formations sealed against pollution?
 yes, no.

If YES depth of formation 10 feet

Why Health Dept. requirement

Drillers Remarks:

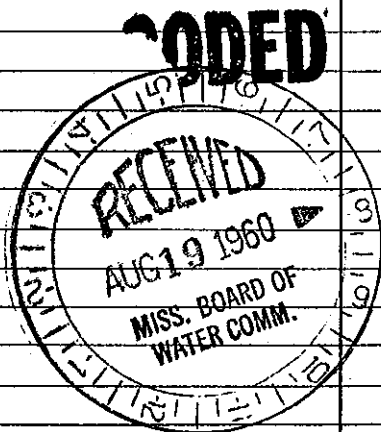

(Use Back Side)

Well No.

Mail this copy to Board of Water Commissioners 429 Miss. St. Jackson, Miss