

George MISSISSIPPI BOARD OF WATER COMMISSIONERS

J21

4-22-66

WATER WELL DRILLERS LOG

CODED

Date: 4-22 1966, Driller: H.D. Rydell County George
(Name)

(1) Owner of Land:	Description & Color of Materials Sand, Clay, Red Clay, Shell, etc.	Thick- ness Feet	Depth Feet
<u>Charles Ferguson Sr.</u> (Name)	<u>Red Clay</u>	<u>10</u>	<u>10</u>
<u>Passing only</u> (Address)	<u>Coarse Sand</u>	<u>32</u>	<u>42</u>
(2) Location: <u>3/4</u> , <u>3/4</u> , Sec. <u>J</u> T <u>3</u> R <u>8</u>	<u>Blue Clay</u>	<u>105</u>	<u>147</u>
<u>20</u> miles <u>West</u> of <u>Trichale</u> (distance) (direction) (Nearest Town)	<u>Sand Med-Coarse</u>	<u>37</u>	<u>184</u>
(3) Topography: <input checked="" type="checkbox"/> (Hilly) <input type="checkbox"/> (Flat) <input type="checkbox"/> (Level)			
(4) Purpose of Well: <u>Camp</u> (Domestic Irrigation Municipal, Industrial, Other)			

Information upon completion of well:

- (1) Diameter 2" inches.
- (2) Total Depth 184 feet.
- (3) Water Level 14 1/2 feet above below top of ground.
- (4) Cased to _____, Size _____.
- (5) Screen: Size 2", Length 10.
- (6) Were any formations sealed against pollution?
_____ yes, no.


If YES depth of formation _____

Why _____

Drillers Remarks: This well

gave me trouble by
flowing out around pipe
I stop it with a packer

CODED

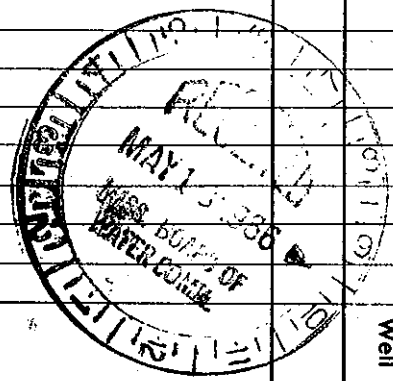

(Use Back Side)

Well No. _____

Mail this copy to Board of Water Commissioners 429 Miss. St. Jackson, Miss