

STONE MISSISSIPPI BOARD OF WATER COMMISSIONERS

~~George~~ George J 23

2-6-62

WATER WELL DRILLERS LOG CODED George

Date: Feb 6, 1962, Driller: C. T. SWITZER WELL CO County: Stone

(Name)

(1) Owner of Land:	Description & Color of Materials Sand, Clay, Red Clay, Shell, etc.	Thick- ness Feet	Depth Feet
D. M. Weaver (Name)	Clay	00	20
274 Bay 13 Parkington, Miss (Address)	Sand	20	25
(2) Location: 1/4, 1/4, Sec. 23 35 9 W T R	Clay	25	85
2 miles E of Co. Ave (distance) (direction) of (Nearest Town)	Sand, gravel	85	100
(3) Topography: X (Hilly) (Flat) (Level)	Sand	100	104
(4) Purpose of Well: Domestic (Domestic Irrigation Municipal, Industrial, Other)	Clay	104	180
	Sand, gravel	180	220
	Sand, gravel	220	235

Information upon completion of well:

- (1) Diameter 2" inches.
- (2) Total Depth 235 feet.
- (3) Water Level 15' feet below top of ground.
- (4) Cased to 235', Size 2"
- (5) Screen: Size 2", Length 10'
- (6) Were any formations sealed against pollution?
 yes, no.


from driller
3/1/62
REN

Location

If YES depth of formation _____

Why: Health Dept. Requirement

Drillers Remarks: _____

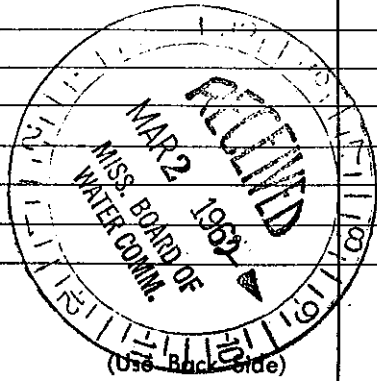

Well No. _____

Mail this copy to Board of Water Commissioners 429 Miss. St. Jackson, Miss.