

# State Well Report

## Part 1

Mississippi Department of Environmental Quality  
Office of Land and Water Resources  
P.O. Box 10631  
Jackson, MS 39289-0631  
(601)961-5210  
(601)354-6938 (fax)

County: George  
Permit #: \_\_\_\_\_  
Driller: Coast Water Wells SRV  
Date drilling completed: 11-14-06

**For Office Use Only:**

Aquifer: \_\_\_\_\_  
Well #: J-61  
L. S. Elevation: \_\_\_\_\_  
E-log #: \_\_\_\_\_

**State Law requires that this report be prepared by the driller in detail and filed with the Department within 30 days of completion of drilling of the well.**

Well Owner Information	Well Location
Owner Name: <u>Burnis Harvard</u>	Latitude: <u>30° 47' 94"</u> Longitude: <u>88° 48' 75"</u>
Mailing Address: <u>Broome School Rd.</u>	Method of Lat/Long (circle one): Conventional Survey, <u>56</u>
<u>Perkinston MS 39573</u>	USGS quad, <u>(Hand-held GPS)</u> Survey-grade GPS
City State Zip Code	<u>SE</u> 1/4 <u>NW</u> 1/4 Sec <u>8</u> Twn <u>T35</u> Rng <u>R8W</u>
Telephone No. ( ) _____	Distance Direction Nearest Town
	<u>4 1/2</u> Miles <u>SW</u> of <u>Berndale</u>

**Well Data**

Purpose of Well (circle one) Home Industrial Public Supply Irrigation Fish Culture Other: \_\_\_\_\_

Date well drilling started: 11-13-06 Date well drilling completed: 11-14-06

If flowing, method of flow regulation: Valve N/A Other (describe) \_\_\_\_\_

Static Water Level: 95 feet above or below (circle one) land surface Date measured: 11-14-06

Method of Measurement (circle one) steel tape electric tape air line other: \_\_\_\_\_

Hole depth: 374' Well depth: 374' Well grouted to a depth of 10 feet

Type of grout (circle one): Cement Bentonite Mix

Casing length: 359' feet Casing diameter: 2 inches Type of casing: PVC

Screen length: 15 feet Screen diameter: 2 inches Type of screen: PVC

Screen slot size: .006 inches Setting depth: From 359 feet to 374 feet

Type of completion (circle all applicable): Gravel packed Underreamed Telescoped Open hole Natural Development

Other (describe): \_\_\_\_\_

Top of lap pipe or reduction in casing: N/A feet. If telescoped or more than one screen, describe on back of page

Logs run (circle all applicable) No log run Electric Gamma Ray Density Sonic Neutron Other: \_\_\_\_\_

Name of organization running log(s): N/A

I certify that the well was drilled, constructed, and completed in accordance with all applicable requirements of the Mississippi Department of Environmental Quality and/or the Mississippi Department of Health regulations and state laws.

Jack Ridgdell 0-472 \_\_\_\_\_  
Print Name of Water Well Contractor and License No.


Jack Ridgdell  
Signature of Water Well Contractor

**RECEIVED**  
DEC 11 2006  
BY: OLWR

J-61

If well telescopes please sketch below and show depths.

Ground Level

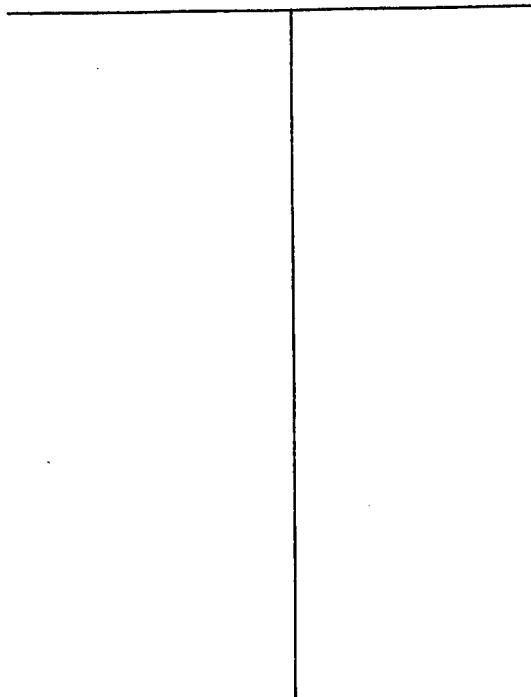

Description of Formations Encountered	From	To
Top Soil	0	2
Orange Clay	2	19
Brown Medium Sand	19	29
Orange, + White Clay	29	52
Blue Clay	52	80
White Medium Sand	80	100
Blue Clay	100	144
Gray Medium Sand	144	163
Blue Clay	163	175
Gray Medium Sand	175	192
Blue Clay	192	234
Gray Medium	234	274

If more than one screen, show location of each on sketch

Sketch the property layout and include the following: 1) the well location; 2) any permanent structures on the property that may aid in locating the well; 3) any roads, power lines, or other items that may aid in locating the property and the well; 4) indicate direction.

**RECEIVED**  
DEC 11 2006  
BY: OLWR

Landowner Name: Burnis Havard

[Signature]  
Signature of Water Well Contractor

# STATE WELL REPORT

## Part 2

**Pump Installer's Completion Report**  
 Mississippi Department of Environmental Quality  
 Office of Land and Water Resources  
 P.O. Box 10631  
 Jackson, MS 39289-0631  
 (601)961-5210  
 (601)354-6938 (fax)

**For Office Use Only:**

Aquifer: \_\_\_\_\_  
 Well #: J-61  
 Elevation: \_\_\_\_\_

County: George  
 Permit #: \_\_\_\_\_  
 Driller: Coast Water Well Srv.  
 Date completed: 11-14-06

**This report should be prepared by the pump installer in detail and filed with the Department within 30 days of the installation of pump.**

Well Owner Information	Well Location
Owner Name: <u>Burnis Havard</u>	Latitude: <u>30°47'941"</u> Longitude: <u>088°48'785"</u>
Mailing Address: <u>Broome School Rd.</u>	Method of Lat/Long (circle one): <u>Conventional Survey</u>
<u>Perkinston, MS 39573</u>	USGS quad, <u>Hand-held GPS</u> , Survey-grade GPS
City                      State                      Zip Code	<u>SE 1/4 NW 1/4 Sec 7 Twn T35 Rng R8W</u>
Telephone No. ( ) _____	Distance                      Direction                      Nearest Town
	<u>4 1/2 Miles S W of Bennosale</u>

Pump Type Circle one	Power Type Circle one
Air Lift <u>Jet</u> Submersible	Diesel Engine                      Gasoline Engine                      Natural Gas
Bucket                      Piston                      Turbine	<u>Electric Motor</u> Hand                      Tractor PTO
Centrifugal                      Rotary                      Flowing Well	Windmill                      Other (specify): _____
Other (specify): _____	Horse Power Rating of Motor: <u>2 HP</u>
Date Pump Installed: <u>11-16-06</u>	Setting Depth: <u>120 Ft. drop pipe</u> feet
Rated Pump Capacity: <u>8.5</u> Gallons Per Minute	Number of Stages: <u>3</u>

Pump Test Data	Method of Measuring Water Level Circle one
Date Well Tested: <u>11-16-06</u>	<u>Air Line</u> Electric Measuring Line                      Steel Tape
Static Water Level (A): <u>95</u> Feet Below Land Surface	Other (specify): _____
Pumping Water Level (B): <u>N/A</u> Feet Below Land Surface	For flowing well, measured shut in head: <u>N/A</u> feet
Drawdown [(B) - (A)]: <u>N/A</u> Feet Below Land Surface	Well yielded <u>8.5</u> GPM with a drawdown of
Test Pumping Rate: <u>8.5</u> Gallons Per Minute	<u>N/A</u> feet after <u>N/A</u> hours of pumping
Duration of Pump Test (minimum 4 hours): <u>4</u> hours	

I HEREBY CERTIFY that the above statements are true to the best of my knowledge.

John Elkins 0-716P                      [Signature] 0-716P  
 Print Name of Pump Installer and License No. (if applicable)                      Signature of Pump Installer

**RECEIVED**  
 DEC 11 2006  
 BY: OLWR