	State Wel	l Report	For Office Use Only:
county: George	Part 1		-
	Mississippi Department of Office of Land and	Environmental Quality	Aquifer:
Permit #:	P.O. Box		Well #: J-65
Driller COast Water WellsRV.	Jackson, MS		L. S. Elevation:
Date drilling completed: 1-8-0-7	(601)961 (601)354-6		E-log #:
State Law requires that this rep	ort be prepared by the dr	iller in detail and filed w	ith the Department with
30 days of completion of drilling	g of the well.		Location
Well Owner Inform			
Owner Name DCAAIeBrabsto	$\frac{r_1}{1}$	atitude: <u>30 • 33 </u> • 511 48 _ 19	48 Z
Mailing Address: BUT NIS HAV a	rdRD. N	lethod of Lat/Long (circle or	ne): Conventional Survey,
		•	GPS Survey-grade GPS
Perkinston, M	<u>15 39573</u>	The 1/4 NE 1/4 Sec 16	<u>E</u> Twn <u>735</u> Rng <u>R</u> 8
•		NE NW Distance Direction	
Telephone No. (208) 218-2106		4 Miles West	of Bennoole
Method of Measurement (circle one) s Hole depth: <u>370 FT</u> . Well de Type of grout (circle one): Cement	Bentonite Mix	Well grouted to a depth of	<u>10</u> feet
Casing length: 375 feet Casi			
1=	-		D_{VC}
Screen length: 15 feet Screen	een diameter:i	nches Type of screen:	
Screen length: 15 feet Screen	-	nches Type of screen:	
Screen length: <u>15</u> feet Screen slot size: <u>004</u> inches	een diameter:i Setting depth: From <u>3</u>	nches Type of screen: 1 75 feet to 3°	<u>70</u> feet
Screen length: <u>15</u> feet Screen slot size: <u>004</u> inches	een diameter:i Setting depth: From <u>3</u> Gravel packed Underread	nches Type of screen: 1 75 feet to 3°	10 feet hole Natural Development
Screen length: <u>15</u> feet Screen slot size: <u>004</u> inches Type of completion (circle all applicable):	cen diameter:i Setting depth: From <u>3</u> Gravel packed Underreat Other (describe):	nches Type of screen: 1 75 feet to 3° med Telescoped Open	10 feet hole Natural Development
Screen length: <u>15</u> feet Screen Screen slot size: <u>004</u> inches Type of completion (circle all applicable): Top of lap pipe or reduction in casing: <u>1</u>	een diameter:i Setting depth: From <u>3</u> Gravel packed Underread Other (describe): <u>VA</u> feet. If telesc	nches Type of screen: 1 75 feet to 3° med Telescoped Open oped or more than one screen	hole Natural Development
Screen length: feet Screen Screen slot size: OOH inches Type of completion (circle all applicable): Top of lap pipe or reduction in casing: Logs run (circle all applicable): No log ru Name of organization running log(s):	een diameter:i Setting depth: From <u>3</u> Gravel packed Underreat Other (describe): UAfeet. If telesc Dip Electric Gamma Ray D	nches Type of screen: 75feet to med Telescoped Open oped or more than one scree Density Sonic Neutron	POfeet hole Natural Development een, describe on back of page Other:
Screen length: <u>15</u> feet Screen Screen slot size: <u>004</u> inches Type of completion (circle all applicable): Top of lap pipe or reduction in casing: <u>1</u> Logs run (circle all applicable): No log run Name of organization running log(s): <u>1</u> I certify that the well was drilled, constr	een diameter:	nches Type of screen:	POfeet hole Natural Development een, describe on back of pag Other: requirements of the Mississ
Screen length: feet Screen Screen slot size: OOH inches Type of completion (circle all applicable): Top of lap pipe or reduction in casing: Logs run (circle all applicable): No log ru Name of organization running log(s):	een diameter:	nches Type of screen:	POfeet hole Natural Development een, describe on back of pag Other: requirements of the Mississ

1		14	4	age of
jn -	. s	÷ 1 –		1.1.1
		÷	×.	


If well telescopes please sketch below and show depths.

Ground Level

.

 Description of Formations Encountered	From	To
Orange Clay Brown Conrse Sand Granget Plue Clay W/streaksof Sand	25	15
Gray Medium Sand	350	390

If more than one screen, show location of each on sketch

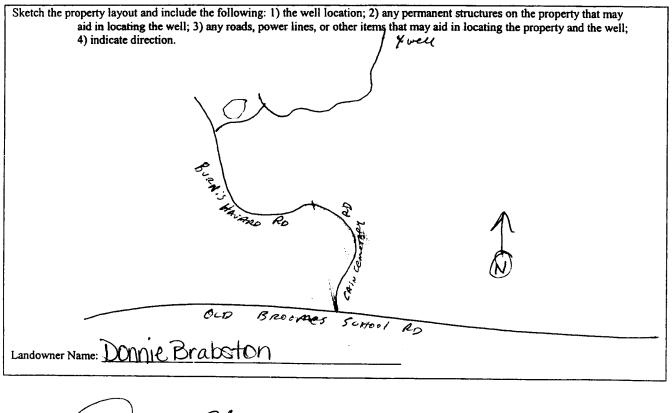

du Signature of Water Well Contractor

NOTICE TO OWNERS OF NEW WATER WELLS

7-

THE MISSISSIPPI DEPARTMENT OF ENVIRONMENTAL QUALITY REQUIRES THIS WELL BE TESTED ACCORDING TO THE MISSISSIPPI STATE BOARD OF HEALTH STANDARDS, AND PASS THE TEST, BEFORE BEING CONSUMED OR USED AS A POTABLE WATER SOURCE.

This well needs to be run constantly for a period of two to three weeks before testing. After running the well, contact your local Health Department's Environmental Office, or a state certified laboratory to have the water tested for bacteria.

Following the test, the Health Department or laboratory will advise you as to whether your well is safe for human consumption or if further chlorination is required.

If your water passes the test, we need a copy of the results so we can forward it to the Mississippi Department of Environmental Quality as required by state regulations.

If your water fails the test, chlorination of the pump system, chlorination of the well and pump system, or a chlorinator may be required. Please contact us at Coast Water Well Service, Inc. if we can be of assistance in these processes.

Water well contractor (signature): Fall Reflect 0-472
Purchaser/Customer (signature): Done But Stor
Purchaser Name (printed): Donnie Brabston
Purchaser Mailing Address: Burnie Hnound Rd. Perkington Mrs 39573
Purchaser Phone Numbers: 228-218-2106
Date signed:/ -5-07
HELPFUL INFORMATION:
Coast Water Well Service (228) 826-9275 Jackson County Health Department Environmental Office (228) 875-1336 Harrison County Health Department Environmental Office (228) 831-5398

Micro-Methods Laboratory ----- (228) 875-6420

Coast Chlorinator ----- (228) 392-2085

COST TO CHLORINATE WELL AND PUMP SYSTEM \$200.00

APPROXIMATE COST OF CHLORINATOR SYSTEM INSTALLED \$850.00

	STATE WI	ELL REPORT	
County: GEOrge Permit #: Drille: COSt Water Well SRV. Date completed:	Pump Installer ² Mississippi Departmen Office of Land P.O. J Jackson, M (601	art 2 s Completion Report at of Environmental Quality and Water Resources Box 10631 4S 39289-0631) 961-5210 54-6938 (fax)	For Office Use Only: Aquifer: Well #: Elevation:
This report should be prepared by th			rtment within 30 days of the
installation of pump.			Well Location
Well Owner Informat Owner Name: DONNIE Brak Mailing Address: Burnis Hava	ston		5/1 Longitude 288°44′465″ 30 le one): Conventional Survey, 28
Perkinston, 1 City State Telephone No. 208,218-2104	<u>NS 39573</u> Zip Code	<u>SW % NE</u> % Sec Distance Direction	Tand-held GPS Survey-grade GPS <u>6</u> Twn <u>T3S</u> Rng <u>R8W</u> on Nearest Town Tof <u>Bernndal</u>
Pump Type		L	Power Type
Circle one			Circle one
Air Lift Jet	Submersible	Diesel Engine Ga	soline Engine Natural Gas
Bucket Piston	Turbine	Electric Motor Ha	and Tractor PTO
Centrifugal Rotary	Flowing Well	Windmill Of	her (specify):
Other (specify):		Horse Power Rating of M	otor: 211P
Date Pump Installed: 5-21-0	8	Setting Depth: 100F	TDroppipeiser
0	Gallons Per Minute	Number of Stages:	
Pump Test Data		Mathadal	Measuring Water Level
			Circle one
Date Well Tested:5-21-08 Static Water Level (A):Feet Pumping Water Level (B):Feet 1	Below Land Surface		Measuring Line Steel Tape
Drawdown [(B) - (A)]:Feet		For flowing well measure	ed shut in head: <u>N/A</u> feet
	Gallons Per Minute		GPM with a drawdown of
Duration of Pump Test (minimum 4 hours):	1		er <u>NA</u> hours of pumping
I HEREBY CERTIFY that the above statem John Elkins 0-71 Print Name of Pump Installer and License N	6f	f my knowledge. John Elfun Signature of Pun	PECEIVED PECEIVED JUN 19 2008 BY: OLWF