

State Well Report

Part 1

Mississippi Department of Environmental Quality
Office of Land and Water Resources
P.O. Box 10631
Jackson, MS 39289-0631
(601) 961-5210
(601) 354-6938 (fax)

For Office Use Only:

Aquifer: _____

Well #: J87

L. S. Elevation: _____

E-log #: _____

County: George

Permit #: _____

Driller: Coast Water Well Serv.

Date drilling completed: 4-23-12

State Law requires that this report be prepared by the driller in detail and filed with the Department within 30 days of completion of drilling of the well.

Well Owner Information	Well Location
Owner Name: <u>Arlene Mallette</u>	Latitude: <u>30° 46' 56.04"</u> Longitude: <u>88° 50' 41.70"</u>
Mailing Address: <u>Beaunes School Road</u>	Method of Lat/Long (circle one): <u>Hand-held GPS</u> Survey-grade GPS
<u>Perrinton</u> Ms. <u>39573</u>	USGS quad: <u>56</u> Survey-grade GPS
City State Zip Code	<u>SE</u> <u>SW</u> 1/4 Sec <u>13</u> ✓ Twn <u>T35</u> ✓ Rng <u>R9W</u> ✓
Telephone No. <u>(228) 219-0822</u>	Distance <u>6</u> Miles Direction <u>SSW</u> of Nearest Town <u>Berwyn</u>

Well Data
Purpose of Well (circle one): <u>Home</u> Industrial Public Supply Irrigation Fish Culture Other: _____
Date well drilling started: <u>4/23/12</u> Date well drilling completed: <u>4/23/12</u>
If flowing, method of flow regulation: Valve <u>N/A</u> Other (describe) _____
Static Water Level: <u>2</u> feet above <u>below</u> (circle one) land surface Date measured: <u>4/23/12</u>
Method of Measurement (circle one) steel tape electric tape <u>air line</u> other: _____
Hole depth: <u>330 FT</u> Well depth: <u>330 FT</u> Well grouted to a depth of <u>10</u> feet
Type of grout (circle one): Cement <u>Bentonite</u> Mix
Casing length: <u>330</u> feet Casing diameter: <u>2</u> inches Type of casing: <u>PVC</u>
Screen length: <u>10</u> feet Screen diameter: <u>2</u> inches Type of screen: <u>PVC</u>
Screen slot size: <u>.006</u> inches Setting depth: From <u>330</u> feet to <u>330</u> feet
Type of completion (circle all applicable): Gravel packed Underreamed Telescoped Open hole <u>Natural Development</u>
Other (describe): _____
Top of lap pipe or reduction in casing: <u>N/A</u> feet. If telescoped or more than one screen, describe on back of page
Logs run (circle all applicable): <u>No log run</u> Electric Gamma Ray Density Sonic Neutron Other: _____
Name of organization running log(s): <u>N/A</u>

I certify that the well was drilled, constructed, and completed in accordance with all applicable requirements of the Mississippi Department of Environmental Quality and/or the Mississippi Department of Health regulations and state laws.

Jack Ridgell 0-472
Print Name of Water Well Contractor and License No.


Jack Ridgell
Signature of Water Well Contractor

RECEIVED

MAY 04 2012
Lewis Printing - Pascagoula, MS
BY: OLWR

If well telescopes please sketch below and show depths.


Ground Level

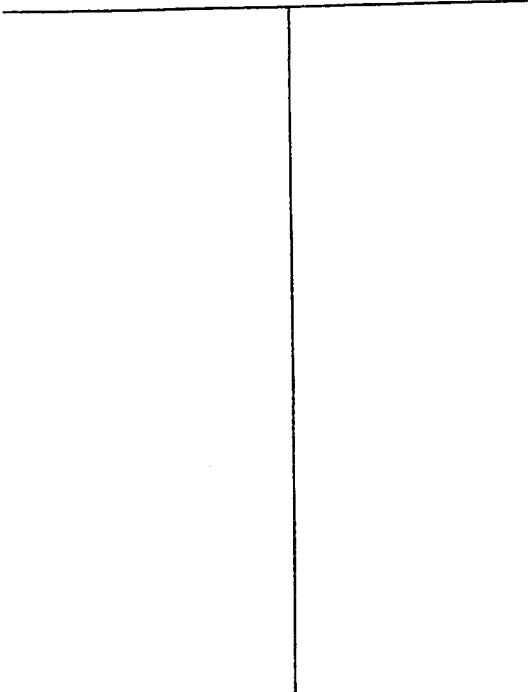

Description of Formations Encountered	From	To
White, coarse Sand	0	32
Blue Clay	32	82
White, coarse Sand	82	107
Blue Clay	107	287
Gray medium Sand	287	330

If more than one screen, show location of each on sketch

Sketch the property layout and include the following: 1) the well location; 2) any permanent structures on the property that may aid in locating the well; 3) any roads, power lines, or other items that may aid in locating the property and the well; 4) indicate direction.

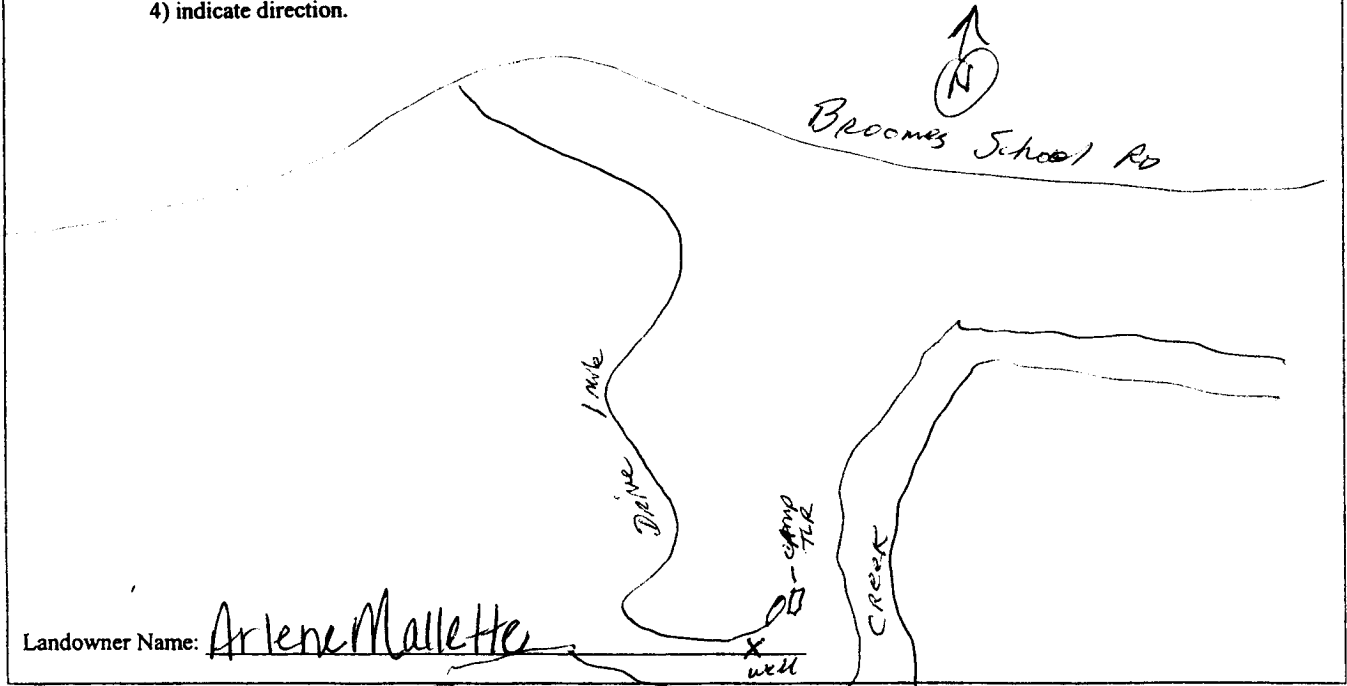

Landowner Name: Arlene Mallette

John Riddle
Signature of Water Well Contractor

RECEIVED

MAY 04 2012

Lewis Printing - Pascagoula, MS
BY: OLWR

STATE WELL REPORT

Part 2

Pump Installer's Completion Report
 Mississippi Department of Environmental Quality
 Office of Land and Water Resources
 P.O. Box 10631
 Jackson, MS 39289-0631
 (601) 961-5210
 (601) 354-6938 (fax)

For Office Use Only:

Aquifer: JET
 Well #: _____
 Elevation: _____

County: George
 Permit #: _____
 Driller: Const Water Wells RV.
 Date completed: 4-23-12

This report should be prepared by the pump installer in detail and filed with the Department within 30 days of the installation of pump.

Well Owner Information	Well Location
Owner Name: <u>Arlene Mallette</u>	Latitude: <u>30° 46' 56.04"</u> Longitude: <u>088° 50' 41.70"</u>
Mailing Address: <u>Brooms School Rd.</u>	Method of Lat/Long (circle one): Conventional Survey,
<u>Perkinston, MS 39573</u>	USGS quad, <u>(Hand-held GPS)</u> Survey-grade GPS
City State Zip Code	<u>SW 1/4 SE 1/4 Sec 13 Twn T3S Rng R9W</u>
Telephone No. <u>228 497-2523</u>	Distance <u>6</u> Miles Direction <u>SSW</u> of Nearest Town <u>Benndale</u>

Pump Type Circle one	Power Type Circle one
Air Lift <input type="radio"/> Jet <input checked="" type="radio"/> Submersible	Diesel Engine Gasoline Engine Natural Gas
Bucket <input type="radio"/> Piston <input type="radio"/> Turbine	<input checked="" type="radio"/> Electric Motor <input type="radio"/> Hand <input type="radio"/> Tractor PTO
Centrifugal <input type="radio"/> Rotary <input type="radio"/> Flowing Well	Windmill Other (specify): _____
Other (specify): _____	Horse Power Rating of Motor: <u>2 HP</u>
Date Pump Installed: <u>5/9/12</u>	Setting Depth: <u>40 FT. Drop Pipe</u> feet
Rated Pump Capacity: <u>14</u> Gallons Per Minute	Number of Stages: <u>3</u>

Pump Test Data	Method of Measuring Water Level Circle one
Date Well Tested: <u>5/9/12</u>	<input checked="" type="radio"/> Air Line <input type="radio"/> Electric Measuring Line <input type="radio"/> Steel Tape
Static Water Level (A): <u>2</u> Feet Below Land Surface	Other (specify): _____
Pumping Water Level (B): <u>N/A</u> Feet Below Land Surface	For flowing well, measured shut in head: <u>N/A</u> feet
Drawdown [(B) - (A)]: <u>N/A</u> Feet Below Land Surface	Well yielded <u>30</u> GPM with a drawdown of
Test Pumping Rate: <u>14</u> Gallons Per Minute	<u>N/A</u> feet after <u>N/A</u> hours of pumping
Duration of Pump Test (minimum 4 hours): <u>4</u> hours	

RECEIVED

JUN 6 2012

BY: OLWF
 Lewis Printing - Pascagoula, MS

I HEREBY CERTIFY that the above statements are true to the best of my knowledge.

Jack Ridgell 0-472 Jack Ridgell
 Print Name of Pump Installer and License No. (if applicable) Signature of Pump Installer