

MISSISSIPPI DEPARTMENT OF NATURAL RESOURCES  
Bureau of Land and Water Resources

Southport Mall  
P.O. Box 10631

Jackson, Mississippi 39209  
WATER WELL DRILLERS LOG

George 4843  
J 284-2048  
Ph. 8-20-81

8-20-81 date well completed  
81 Cross Water Well Sew. firm name  
George county well located

LANDOWNER: Tony Whittington  
618 Utah St.  
Berwick, La. 70342  
(mailing address)


WELL LOCATION:  
sec. 11 T-3 S R-9 W  
21 miles NW of VANDLER  
(distance) (direction) (nearest town)

WELL PURPOSE: Home  
(home, irrigation, municipal, industrial)

WELL COMPLETION DATA:

- (1) diameter (inches) 2"
- (2) total depth (feet) 300'
- (3) static water level (feet) 60' below top of ground.
- (4) casing PVC 290' (material) (depth)  
2" (size) If telescope see back.
- (5) screen 10' 290' (length) (depth to top)  
2" PVC (size) (material)
- (6) pump 1/2 HP. (type power) (yield gpm)  
Check.
- (7) electric log No. (yes or no)
- (8) how well bottom plugged  
Back wash Valve

Description of formations encountered	from	to
Top Soil	0"	6"
Red Clay	6"	11"
Purple Clay	11"	36"
Blue Clay	36"	200'
Blue fine sand	200'	206'
Blue Clay	206'	277'
Gray Med Sand	277'	300'

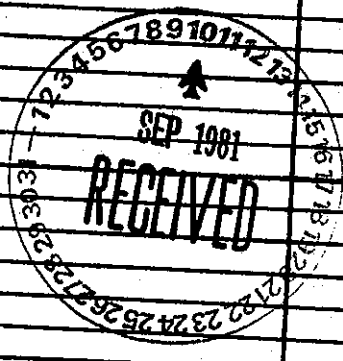

DRILLERS REMARKS: