

MISSISSIPPI BOARD OF WATER COMMISSIONERS

K 14

GEORGE 30 CODED

WATER WELL DRILLERS LOG


3-12-61

COLVILLE

CODED

Date: 3/12, 1961, Driller: Water Supply Co., George

(1) Owner of Land:	Description & Color of Materials Sand, Clay, Red Clay, Shell, etc.	Thick- ness Feet	Depth, Feet
(Name) W H Albritton			
(Address) Basin Drive			
(2) Location: NW 1/4, SW 1/4, Sec 16 T8R7E 33			
(distance) 15 miles, (direction) South, (Nearest Town) Sueda			
(3) Topography: (Hilly) (Flat) (Level)			
(4) Purpose of Well: (Domestic Irrigation) (Municipal, Industrial, Other)			
<p>Information upon completion of well:</p> <p>(1) Diameter 2 inches.</p> <p>(2) Total Depth 477 feet.</p> <p>(3) Water Level 39' 10" feet below top of ground.</p> <p>(4) Cased to _____, Size _____.</p> <p>(5) Screen: Size 2, Length 10'</p> <p>(6) Were any formations sealed against pollution? _____ yes, _____ no. <input checked="" type="checkbox"/></p> <p>If YES depth of formation _____</p> <p>Why _____</p> <p>Drillers Remarks: _____</p>	<p>Depth Form Depth Form</p> <p>0 Clay 160 Rock</p> <p>161 B Clay 166 Sand</p> <p>239 Clay 239 Sand</p> <p>260 Clay 280 Clay</p> <p>350 Clay 399 Sand</p> <p>420 Clay 430 Sand</p> <p>430 Clay 466 Sand</p> <p>477</p> <p>JD</p> <p>Water level</p> <p>39' 10"</p>		

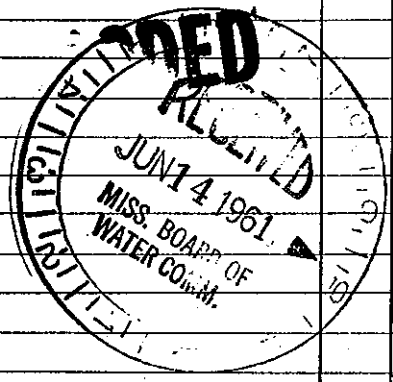

Well No. 271

(Use Back Side)

Mail this copy to Board of Water Commissioners 429 Miss. St. Jackson, Miss