
0	State W	ell Report	
M		-	For Office Use Only:
County: Mise	Part 1 – Driller's Log Mississippi Department of Environmental Qualit		Aquifer: KI4
Permit #:	Office of Land and Water Resources		
Driller. Miket Wade	P.O. Box 2307		Well #:
Dime. 1. Werd Werder		n, MS 39225 961-5210	L. S. Elevation:
Date drilling completed:	(601)961- 5228 (fax)		E-log #:
State Law requires that this report be p	repared by the lice	ense holder responsible for	
Department at the above address within	n 30 days of comp	pletion of drilling of the well	or borehole.
Information on Well Owner			rehole Location
(Landowner if borehole is not for a way Owner Name Ronal Chile		Latitude: 30 . 46,53	" Longitude: 88 . 38 . 67 "
Mailing Address: 33081 /4 44		Method of Lat/Long (circle on	ne): Conventional Survey,
Waining Autress. 0 500 1 A lag		USGS quad, Hand-held	GPS, Survey-grade GPS
PAIM	ZGUKO	SE 1/4 Sec/3	Twn T35 Rng R7W
Lucedal MS	SIESC	Sin	
City State	Zip Code	Distance Direction	of Charles I own
Telephone No. ()			
	Well / Bore	hole Data	
Date drilling started: $\frac{4.26.60}{2}$ Date drilling c	completed: 4-24	10 Hole depth: 7.5	Hole diameter 81/2
Location of the source of any surface water used Method of dosing and volume of Chlorine used	for drilling: <u>NO</u> in drilling and devel	lopment:	
Logs run (circle all applicable): No log run Ele	ectric Gamma Rav	Density Sonic Neutron	Other:
Name of organization running log(s):			
Purpose of borehole (check one): Water Well	Geotechnical/Geol	ogical Investigation Ground	Source Heat Pump
	Other (describe		
If drilling is not related to wa	ter well construction	n, skip the remainder of this bl	ock
Purpose of Well (check one): Home Industri	ial Public Supply	Irrigation Fish Culture	Other:
If a flowing well, method of flow regulation: Val	lve 0	ther (describe)	
Static Water Level:	below (circle one) l	and surface Date measured:	
Method of Measurement (circle one) steel tap	e electric tape	air line other:	
Well depth: 75 Well grouted to a depth of			4
Casing length: <u>55</u> feet Casing dian Screen length: <u>20</u> feet Screen diar	neter: <u>4</u>	inches Type of casing:	8cd 40
Screen length: <u>20</u> feet Screen diar	meter: <u>4</u>	inches Type of screen:	VL wrapped
Screen slot size: <u>2</u> inches Set	tting depth: From	55 feet to 7	5 feet
Type of completion (circle all applicable): Grav	vel packed Under	reamed Telescoped Open	hole Natural Development
Othe	er (describe):		
Top of lap pipe or reduction in casing:	feet. If tel	lescoped or more than one scre	en, describe on next page
			Form: OLWR-SWR-1A (04/08

d'an c

RECEIVED MAY 2 5 2010 BY: OLWR




## The sketch below only required for water wells

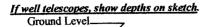

Description of formations encountered must be provided for all wells and boreholes, unless specifically exempted by regulations

From (depth) Ground Level	3 18 50 75
138	3 18 50 75
18 18 50	18 50 75
50	50
50	75
	1
	1
	+
	+
	+
	+

If more than one screen, show location of each on sketch

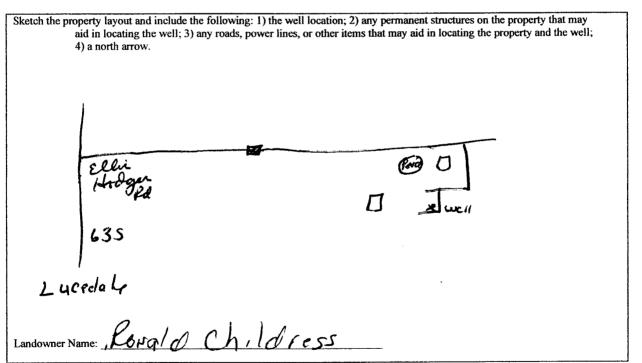

Form: OLWR-SWR-1A (04/08)

I certify that the well/borehole was drilled, constructed, and completed in accordance with all applicable requirements of the Mississippi Department of Environmental Quality and the Mississippi Department of Health regulations, if applicable, and state

lav Tog 1: 0400 4-26-10 10

Print Name of Responsible Licensee and License No.

Date

MAY 2.5 200 BYOMP

Michael Att

		ELL REPORT art 2		
County Aling	Part 2 Pump Installer's Completion Report Mississippi Department of Environmental Quality Office of Land and Water Resources		For Office Use Only:    Aquifer:	
Permit #:				
Driller: $\underline{7}$ $\underline{4}$ $\underline{7}$ $\underline{5}$ $\underline{7}$	P.O. E	P.O. Box 10631		
Date completed: <u>4 5 5 5 5 5 5 5 5 5 5 5 5 5 5 5 5 5 5 </u>	Jackson, MS 39289-0631 (601)961-5210			
	(601)35	4-6938 (fax)		
installation of pump. A copy			partment within 30 days of the t.	
Well Owner Info	rmation		ll Location	
Owner Name: <u>Forald Childran</u> Mailing Address: <u>33081 Huy 98</u> <u>Lacedol MS 39852</u> City State Zip Code		Latitude:	Longitude:	
		Method of Lat/Long (circle one): Conventional Survey, USGS quad, Hand-held GPS, Survey-grade GPS		
				<sup>1</sup> ⁄4 <sup>1</sup> ⁄4 Sec_/
		Distance Direction	Nearest Town	
		Felephone No. ( )		<u>8</u> Miles <u>5</u>
Pump Typ Circle one			wer Type Circle one	
	Submersible		bline Engine Natural Gas	
Air Lift Jet			-	
Bucket Piston	Turbine	Electric Motor Har		
Centrifugal Rotary	Flowing Well		er (specify):	
Other (specify): Date Pump Installed: イー ろの・レつ		Horse Power Rating of Motor: 3		
		Setting Depth: 7.		
Rated Pump Capacity:55	Gallons Per Minute	Number of Stages:	<u> </u>	
Pump Test Data			easuring Water Level	
Date Well Tested: 4-30-10			Circle one	
Static Water Level (A): 40 Feet Below Land Surface		Air Line Electric N	1easuring Line Steel Tape	
Pumping Water Level (B): 55 Feet Below Land Surface		Other (specify):		
Drawdown [(B)-(A)]: Feet Below Land Surface		For flowing well, measured	I shut in head:feet	
Test Pumping Rate: 65 Gallons Per Minute		Well yielded GPM with a drawdown of		
Duration of Pump Test (minimum 4	hours): <u> </u>	<u>/</u> <u>S</u> feet afte	r <u>112</u> hours of pumping	
HEREBY CERTIFY that the above	e statements are true to the be	est of my knowledge.	104	
m I IPE	y Fugle 0408	nil	VKJA	

MAY 2.5.200