

MISSISSIPPI DEPARTMENT OF NATURAL RESOURCES

Bureau of Land and Water Resources

Southport Mall

P.O. Box 10631

Jackson, Mississippi 39209

WATER WELL DRILLERS LOG

GEORGE
K 2049
4-16-81
4-16-81

Engle well since George
firm name county well located

LANDOWNER: Bill Scott

description of formations encountered

from to

(mailing address)

WELL LOCATION:

sec. 32 T. 22 N. R. 76 E.
6 miles S of Stredale
(distance) (direction) (nearest town)


Top Soil	0	5
Sand	5	25
Clay	25	30
Sand	30	36
Clay	36	42
med Sand	42	60
Coarse Sand	60	70

WELL PURPOSE:

(home) Irrigation, municipal, industrial

WELL COMPLETION DATA:

- (1) diameter (inches) 4"
- (2) total depth (feet) 70'
- (3) static water level (feet) 31' below top of ground.
- (4) casing PVC, 60' (material), (depth)
4" (size) If telescope see back.
- (5) screen 10', 60' (length), (depth to top)
4" (size), PVC (material)
- (6) pump 1/3 (HP), 21 (yield gpm)
Ek (type power)
- (7) electric log (yes or no) (no)
- (organization running log)
- (8) how well bottom plugged 2" PVC
Backwash

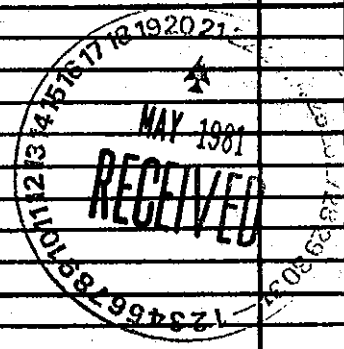

DRILLERS REMARKS: