

MISSISSIPPI
BOARD OF WATER COMMISSIONERS
416 North State Street
Jackson, Mississippi 39201

WATER WELL DRILLERS LOG

CODED

George
L 16
11-63

Nov 27 1963 Colton Water Supply George
date well completed firm name county well located

LANDOWNER: W. S. Smith
Smith
Boston Community
(mailing address)

description of formations encountered	from	to
<u>Clay</u>	<u>0</u>	<u>16</u>
<u>Sand</u>	<u>16</u>	<u>110</u>

WELL LOCATION:
sec. 33 T 3 N R 6 E
11 miles South of Jucydah
(distance) (direction) (nearest town)

WELL PURPOSE: domestic
(home, irrigation, municipal, industrial)

WELL COMPLETION DATA:

(1) diameter (inches) 2

(2) total depth (feet) 115

(3) static water level (feet) 50 ^{below} above top of ground.

(4) casing (material) (depth) _____
(size) if telescope see back.


(5) screen 10 105
(length) (depth to top)
2 brass
(size) (material)

(6) pump _____ (HP) _____ (yield gpm)
(type power)

(7) electric log no
(yes or no)
(organization running log)

(8) how well bottom plugged BPCable

CODED

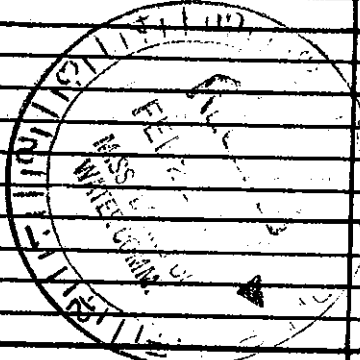

DRILLERS REMARKS: