

MISSISSIPPI BOARD OF WATER COMMISSIONERS

L 19
8-30-62

WATER WELL DRILLERS LOG

CODED


Date: 8-30, 1962, Driller: George Colville County George
(Name)

	Description & Color of Materials Sand, Clay, Red Clay, Shell, etc.	Thick- ness Feet	Depth Feet
(1) Owner of Land: <u>Wayne Lee</u> (Name)	<u>Red Clay</u>	<u>15</u>	<u>15</u>
<u>Barton Community, Lucedale</u> (Address) <u>Miss.</u>	<u>Sand & gravel</u>	<u>27</u>	<u>42</u>
(2) Location: <u>SE 1/4, NE 1/4, Sec. 9 T38R6W</u>	<u>sand/clay streaks</u>	<u>32</u>	<u>74</u>
<u>10</u> miles <u>South</u> of <u>Lucedale</u> (distance) (direction) (Nearest Town)	<u>Pink Clay</u>	<u>10</u>	<u>84</u>
(3) Topography: <u>Hilly</u> (Hilly) (Flat) (Level)	<u>Sand</u>	<u>6</u>	<u>100</u>
(4) Purpose of Well: <u>Domestic</u> (Domestic Irrigation Municipal, Industrial, Other)	<u>Clay</u>	<u>5</u>	<u>105</u>
	<u>sand</u>	<u>31</u>	<u>136</u>

Information upon completion of well:

- (1) Diameter 2 inches.
- (2) Total Depth 136 feet.
- (3) Water Level 32 feet below top of ground.
- (4) Cased to _____, Size _____
- (5) Screen: Size No. 8 gal. Length 10'
- (6) Were any formations sealed against pollution?
_____ yes, ✓ no.

CODED

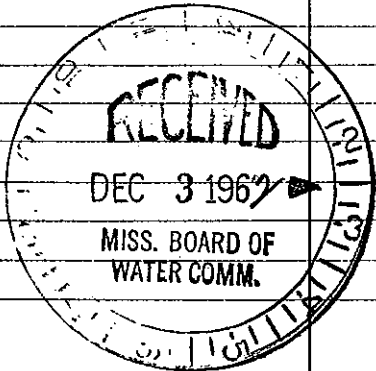

(Use Back Side)

Well No. 475

Mail this copy to Board of Water Commissioners 429 Miss. St. Jackson, Miss.