

George

MISSISSIPPI BOARD OF WATER COMMISSIONERS

L20

10-5-62

WATER WELL DRILLERS LOG

CODED

Date: Oct 5, 1962, Driller: Flim Cahille County George

(Name)

(1) Owner of Land:	Description & Color of Materials Sand, Clay, Red Clay, Shell, etc.	Thick- ness Feet	Depth Feet
Wayne See (Name) Sucedale Min (Address)	0-15 red clay		
(2) Location: NE 1/4, NE 1/4, Sec. 9 T.35R.6W. 10 miles South, of Sucedale. (distance) (direction) (Nearest Town)	15-63 sand and gravel		
(3) Topography: Hilly (Hilly) (Flat) (Level)	68-74 streaked		
(4) Purpose of Well: Domestic (Domestic Irrigation Municipal, Industrial, Other)	74-84 pink clay		
	84-100 sand		
	100-105 clay		
	105-147 sand		
	TD		

Information upon completion of well:


- (1) Diameter 2" inches.
- (2) Total Depth 147 feet.
- (3) Water Level 65' 6" feet below top of ground.
- (4) Cased to \_\_\_\_\_, Size \_\_\_\_\_
- (5) Screen: Size 2" Length 10'
- (6) Were any formations sealed against pollution?  
\_\_\_\_\_ yes, \_\_\_\_\_ no.

If YES depth of formation \_\_\_\_\_

Why \_\_\_\_\_

Drillers Remarks: \_\_\_\_\_

CODED

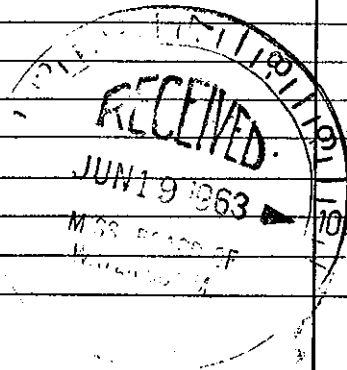

(Use Back Side)

Well No. 180

Mail this copy to Board of Water Commissioners 429 Miss. St. Jackson, Miss.