

George
L22
10-28-68

MISSISSIPPI
 BOARD OF WATER COMMISSIONERS
 416 North State Street
 Jackson, Mississippi 39201

CODED

WATER WELL DRILLERS LOG


October 28 1968 M. & H. Well Co. George
 date well completed firm name county well located

LANDOWNER	description of formations encountered	from	to
<u>L. C. Williams</u>	<u>Red sand</u>	<u>0</u>	<u>20'</u>
<u>Sucadal, Miss.</u>	<u>sand + clay</u>	<u>20'</u>	<u>115'</u>
(mailing address)	<u>Gravel + water sand</u>	<u>115'</u>	<u>130'</u>

WELL LOCATION:
 sec. 20 T. 3 N. R. 6 E
2 1/2 miles S of Basin
 (distance) (direction) (nearest town)

WELL PURPOSE: Home
 (home, irrigation, municipal, industrial)

- WELL COMPLETION DATA:
- (1) diameter (inches) 2"
 - (2) total depth (feet) 130'
 - (3) static water level (feet) 40' below above top of ground.
 - (4) casing Plastic, 120'
 (material) (depth)
no if telescope see back.
 (size)
 - (5) screen 10', 120'
 (length) (depth to top)
2", plastic
 (size) (material)
 - (6) pump 1 12 gal.
 (HP) (yield gpm)
Electric
 (type power)
 - (7) electric log no
 (yes or no)
 (organization running log)
 - (8) how well bottom plugged
Backwash Valve

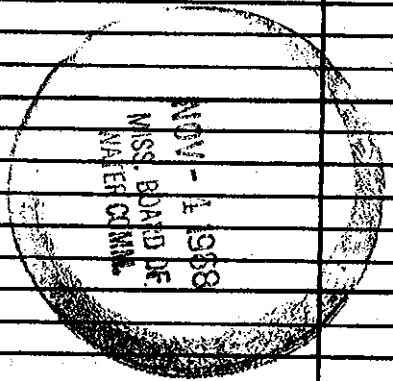

DRILLERS REMARKS: