

GEORGE
 L34
 8-15-70

MISSISSIPPI
 BOARD OF WATER COMMISSIONERS
 416 North State Street
 Jackson, Mississippi 39201

Corrected
 10/30/70

CODED


WATER WELL DRILLERS LOG

8-15-1970 date well completed
 CHAD Drilling firm name
 George county well located

LANDOWNER: W F Moore
 RT #1
 Suedale miss
 (mailing address)

description of formations encountered
 Sand
 from 1 to 18

WELL LOCATION:
 sec 14 T-3 N R 6 E
 10 miles (distance) S of Suedale (nearest town)

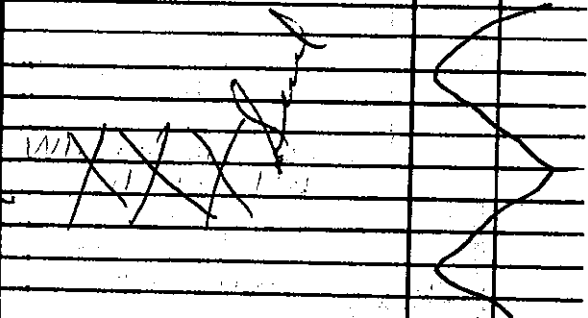

WELL PURPOSE: Home
 (home, irrigation, municipal, industrial)

WELL COMPLETION DATA:
 (1) diameter (inches) 2"
 (2) total depth (feet) 120
 (3) static water level (feet) 50 below top of ground
 (4) casing (material) Plastic 110 (depth)
 (5) screen 10 ft 110 (length) (depth to top)
 2" (size) Plastic (material)
 (6) pump 1 (HP) 350 (yield gpm)
 REA (type power)
 (7) electric log (yes or no)

18 63
 clay
 Sand
 63 110
 110 120

CODED

AUG 26 1970

(8) how well bottom plugged
 Wash with valve

MISS. BD. OF
 WATER COMM.

DRILLERS REMARKS:

TOTAL 120