

George
L 68
4-1-74

MISSISSIPPI
BOARD OF WATER COMMISSIONERS
416 North State Street
Jackson, Mississippi 39201

WATER WELL DRILLERS LOG

CODED
George

4-1-74 date well completed 1974 M+H Steel Co firm name George county well located

LANDOWNER: Grain Elevator
Lucedale Miss
(mailing address)

description of formations encountered	from	to
Dirt	0	1
Red Dirt	1	12
Red Clay	12	21
Sand	21	26
Red Clay	26	41
White Clay	41	59
Sand	59	84


WELL LOCATION:
sec 20 T 3 N R 6 E
11 miles (distance) S (direction) of Lucedale (nearest town)

WELL PURPOSE: Grain Elevator
(home, irrigation, municipal, industrial)

WELL COMPLETION DATA:
(1) diameter (inches) 2"
(2) total depth (feet) 84
(3) static water level (feet) 55 ^{below} _{above} top of ground
(4) casing Plastic 79 (material) (depth)
(size) If telescope see back.
(5) screen 5 79 (length) (depth to top)
5 Plastic (size) (material)
(6) pump 1 12 (HP) (yield/gpm)
Electric (type power)
(7) electric log (yes or no)

CODED

(organization running log)
(8) how well bottom plugged Back Wash Valve

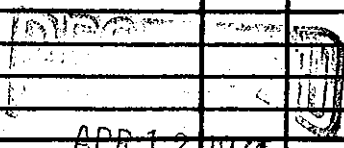

APR 12 1974

DRILLERS REMARKS:

MISS. BD. OF WATER COMM