

George  
L 70  
5-24-74

MISSISSIPPI  
BOARD OF WATER COMMISSIONERS  
416 North State Street  
Jackson, Mississippi 39201

CODED

WATER WELL DRILLERS LOG

5-24, 1974 M & H Skellen George  
Date well completed firm name county well located

LANDOWNER: Schait Stord  
Lucedale Miss  
(mailing address)

WELL LOCATION:  
sec. 21 T. 3 N. R. 6 E.  
9 miles S Lucedale  
(distance) (direction) (nearest town)

WELL PURPOSE: Home  
(home, irrigation, municipal, industrial)

WELL COMPLETION DATA:

(1) diameter (inches) 2"

(2) total depth (feet) 115

(3) static water level (feet) 40 <sup>below</sup> above top of ground

(4) casing Plastic 105  
(material) (depth)  
(size) if telescope see back.

(5) screen 10ft 105  
(length) (depth to top)  
2" Plastic  
(size) (material)


(6) pump 1 8  
(HP) (yield gpm)  
Electric  
(type power)

(7) electric log \_\_\_\_\_  
(yes or no)

(organization running log)

(8) how well bottom plugged Back  
wash valve

| description of formations encountered | from | to  |
|---------------------------------------|------|-----|
| Dirt                                  | 0    | 2   |
| Red Dirt                              | 2    | 11  |
| Red Clay                              | 11   | 21  |
| Sand                                  | 31   | 31  |
| Yellow Sand                           | 31   | 54  |
| White Sand                            | 54   | 54  |
| Coarse Sand                           | 54   | 115 |

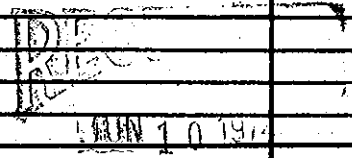

MISS. BD. OF WATER COMMISSIONERS