


George
L 77
3-17-75

MISSISSIPPI
 BOARD OF WATER COMMISSIONERS
 416 North State Street
 Jackson, Mississippi 39201

WATER WELL DRILLERS LOG

3/17 1975 M. H. Well Co. George
 date well completed firm name county well located

LANDOWNER: <u>Ray Bush</u>	description of formations encountered	from	to
<u>Lucedale Miss</u>	<u>Dirt</u>	<u>0</u>	<u>1</u>
(mailing address)	<u>Red Dirt</u>	<u>1</u>	<u>5</u>
WELL LOCATION:	<u>Red Clay</u>	<u>15</u>	<u>15</u>
sec <u>34</u> T <u>3</u> N R <u>6</u> E <u>11</u> miles <u>S</u> of <u>Lucedale</u> (distance) (direction) (nearest town)	<u>Sand</u>	<u>15</u>	<u>21</u>
	<u>Yellow Clay</u>	<u>21</u>	<u>31</u>
	<u>Sand</u>	<u>31</u>	<u>73</u>
	<u>Blue Clay</u>	<u>73</u>	<u>195</u>
	<u>Sand</u>	<u>195</u>	<u>210</u>
WELL PURPOSE: <u>Home</u> (home, irrigation, municipal, industrial)			
WELL COMPLETION DATA:			
(1) diameter (inches) <u>2"</u>			
(2) total depth (feet) <u>210</u>			
(3) static water level (feet) <u>54</u> ^{below} top of ground			
(4) casing <u>Plastic</u> <u>2.05</u> (material) (depth)			
(size) If telescope see back.			
(5) screen <u>5ft</u> <u>2.05</u> (length) (depth to top)			
<u>2"</u> <u>Plastic</u> (size) (material)			
(6) pump <u>1</u> <u>10</u> (HP) (yield/gpm)			
<u>Electric</u> (type power)			
(7) electric log _____ (yes or no)			
_____ (organization running log)			
(8) how well bottom plugged _____			
DRILLERS REMARKS:			

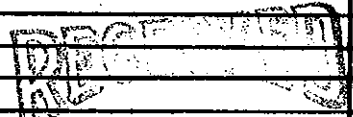

APR 14 1975

MISS. BD. OF WATER COMMISSIONERS