

GEORGE
L 83
2/24/81

MISSISSIPPI
BOARD OF WATER COMMISSIONERS
416 North State Street
Jackson, Mississippi 39201




WATER WELL DRILLERS LOG

2-24-81 date well completed
1981 firm name
county well located

LANDOWNER: MARK BAILEY

description of formations encountered	from	to
Top Soil	0	2
Clay	2	20
Sand	20	25
Clay	25	34
Coarse Sand	34	72
Clay	72	90
Blue Clay	90	220
Blue med Sand	220	300

P.O. Box
Lucedale, MS
(mailing address)

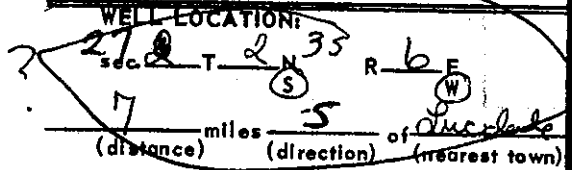

WELL PURPOSE:
(home, irrigation, municipal, industrial)

WELL COMPLETION DATA: 2-24-81

- (1) diameter (inches) 4"
- (2) total depth (feet) 300'
- (3) static water level (feet) 150' ^(below) _(above) top of ground.
- (4) casing PVC 220' (material), (depth)
4" (size) If telescope see back.
- (5) screen 80' 220' (length), (depth to top)
4" PVC (size), (material)
- (6) pump 5 98 (HP), (yield gpm)
EIE (type power)
- (7) electric log (yes or no)

(organization running log)

(8) how well bottom plugged 2" PVC
BACKWASH

DRILLERS REMARKS:

CODED

