

County: George 039
 Permit #: _____
 Driller: Pierce Well
 Date drilling completed: 2/2/05

Well Driller Report and Well Log

Mississippi Department of Environmental Quality
 Office of Land and Water Resources
 P.O. Box 10631
 Jackson, MS 39289-0631
 (601)961-5210
 (601)354-6938 (fax)

For Office Use Only:
 Aquifer: _____
 Well #: L-121
 L. S. Elevation: _____
 E-log #: _____

Pierce Water Well Service

State Law requires that this report be prepared by the driller in detail and filed with the Department within 30 days of completion of drilling of the well.

Well Owner Information	Well Location
Owner Name: <u>James Burges</u>	Latitude: <u>30° 45' 01"</u> Longitude: <u>88° 32' 08"</u>
Mailing Address: <u>Emerson Circle Rd</u> <u>Lucedale MS</u> City State Zip Code	Method of Lat/Long (circle one): Conventional Survey, USGS quad, Hand-held GPS, Survey-grade GPS <u>SW 1/4 SE 1/4 Sec 25 Twn 35 Rng 6W</u>
Telephone No. () _____	Distance Direction Nearest Town <u>2 Miles N of Jackson Collins MS</u>

Well Data

Purpose of Well (circle one) Home Industrial Public Supply Irrigation Fish Culture Other: _____

Date well drilling started: 2-2-05 Date well drilling completed: 2-2-05

If flowing, method of flow regulation: Valve _____ Other (describe) _____

Static Water Level: 20 feet above or below (circle one) land surface Date measured: 2-2-05

Method of Measurement (circle one) steel tape electric tape air line other: _____

Hole depth: 35' Well depth: 35' Well grouted to a depth of 15 feet

Type of grout (circle one): Cement Bentonite Mix

Casing length: 30 feet Casing diameter: 2" inches Type of casing: plastic

Screen length: 5' feet Screen diameter: 2" inches Type of screen: plastic

Screen slot size: 006 inches Setting depth: From _____ feet to _____ feet

Type of completion (circle all applicable): Gravel packed Underreamed Telescoped Open hole Natural Development

Other (describe): _____

Top of lap pipe or reduction in casing: _____ feet. If telescoped or more than one screen, describe on back of page

Logs run (circle all applicable): No log run Electric Gamma Ray Density Sonic Neutron Other: _____

Name of organization running log(s): _____

I certify that the well was drilled, constructed, and completed in accordance with all applicable requirements of the Mississippi Department of Environmental Quality and/or the Mississippi Department of Health regulations and state laws.

Michael Pierce 0296
 Print Name of Water Well Contractor and License No.

Michael Pierce
 Signature of Water Well Contractor

RECEIVED

If well telescopes please sketch below and show depths.


FEB 16 2005
 BY: OLWR

Ground Level L-121

Description of Formations Encountered	From	To
Top Soil	0	10
Clay	10	20
good Sand	20	35

If more than one screen, show location of each on sketch

Sketch the property layout and include the following: 1) the well location; 2) any permanent structures on the property that may aid in locating the well; 3) any roads, power lines, or other items that may aid in locating the property and the well; 4) indicate direction.

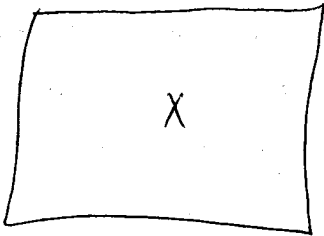

Landowner Name: James Burges

Michael Pierce
Signature of Water Well Contractor

STATE WELL REPORT

Part 2

Pump Installer's Completion Report

Mississippi Department of Environmental Quality
Office of Land and Water Resources
P.O. Box 10631
Jackson, MS 39289-0631
(601)961-5210
(601)354-6938 (fax)

For Office Use Only:

Aquifer: _____
Well #: L-121
Elevation: _____

County: _____
Permit #: _____
Driller: _____
Date completed: _____

This report must be prepared by the pump installer in detail and filed with the Department within 30 days of the installation of pump. A copy of Part 1 of this report must be attached to this report.

Well Owner Information	Well Location
Owner Name: <u>James Burges</u>	Latitude: _____ Longitude: _____
Mailing Address: _____ _____ _____	Method of Lat/Long (circle one): Conventional Survey, USGS quad, Hand-held GPS, Survey-grade GPS
City State Zip Code	<u>S 1/4 SE 1/4 Sec 25 Twn 35 Rng 6W</u>
Telephone No. (____) _____	Distance Direction Nearest Town
	<u>2 Miles N of Jackson Co. Line #613</u>

Pump Type Circle one	Power Type Circle one
Air Lift <input checked="" type="radio"/> Jet Submersible	Diesel Engine Gasoline Engine Natural Gas
Bucket Piston Turbine	<input checked="" type="radio"/> Electric Motor Hand Tractor PTO
Centrifugal Rotary Flowing Well	Windmill Other (specify): _____
Other (specify): _____	Horse Power Rating of Motor: <u>1</u>
Date Pump Installed: <u>2-3-05</u>	Setting Depth: <u>20</u> feet
Rated Pump Capacity: <u>10</u> Gallons Per Minute	Number of Stages: <u>2</u>

Pump Test Data	Method of Measuring Water Level Circle one
Date Well Tested: <u>2-3-05</u>	<input checked="" type="radio"/> Air Line Electric Measuring Line Steel Tape
Static Water Level (A): <u>20</u> Feet Below Land Surface	Other (specify): _____
Pumping Water Level (B): <u>25</u> Feet Below Land Surface	For flowing well, measured shut in head: _____ feet
Drawdown [(B) - (A)]: <u>5</u> Feet Below Land Surface	Well yielded <u>10</u> GPM with a drawdown of
Test Pumping Rate: <u>10</u> Gallons Per Minute	<u>5</u> feet after <u>4</u> hours of pumping
Duration of Pump Test (minimum 4 hours): <u>4</u> hours	

I HEREBY CERTIFY that the above statements are true to the best of my knowledge.

Michael Pierce 02916
Print Name of Pump Installer and License No. (if applicable)

Michael Pierce RECEIVED
Signature of Pump Installer

FEB 16 2005

BY: OLWR