

State Well Report

Part 1

Mississippi Department of Environmental Quality
Office of Land and Water Resources
P.O. Box 10631
Jackson, MS 39289-0631
(601)961-5210
(601)354-6938 (fax)

County: George
Permit #: _____
Driller: Michael S. Havard
Date drilling completed: 04-12-05

For Office Use Only:
Aquifer: _____
Well #: L-128
L. S. Elevation: _____
E-log #: _____

State Law requires that this report be prepared by the driller in detail and filed with the Department within 30 days of completion of drilling of the well.

Well Owner Information	Well Location
Owner Name: <u>Kathleen Rogers</u>	Latitude: <u>30° 48' 24"</u> Longitude: <u>88° 35' 83"</u>
Mailing Address: <u>135 Donato Drive</u>	Method of Lat/Long (circle one): <u>Hand-held GPS</u> <u>57</u> USGS quad: <u>Hand-held GPS</u> , Survey-grade GPS _____
<u>Lucedale</u> MS <u>39452</u>	<u>SW 1/4 NW 1/4</u> Sec <u>54</u> Twn <u>T3S</u> Rng <u>R6W</u>
City State Zip Code	Distance Direction Nearest Twp
Telephone No. <u>(601) 766-0053</u>	<u>8</u> Miles <u>S</u> of <u>Lucedale</u>

Well Data

Purpose of Well (circle one) Home Industrial Public Supply Irrigation Fish Culture Other: _____

Date well drilling started: 04-12-05 Date well drilling completed: 04-12-05

If flowing, method of flow regulation: Valve _____ Other (describe) _____

Static Water Level: 21 feet above or below (circle one) land surface Date measured: _____

Method of Measurement (circle one) steel tape electric tape air line other: 04-12-05

Hole depth: 48 Well depth: 48 Well grouted to a depth of 12 feet

Type of grout (circle one): Cement Bentonite Mix

Casing length: 43 feet Casing diameter: 2 inches Type of casing: PVC 540

Screen length: 5 feet Screen diameter: 2 inches Type of screen: WOP PVC

Screen slot size: .008 inches Setting depth: From 43 feet to 48 feet

Type of completion (circle all applicable): Gravel packed Underreamed Telescoped Open hole Natural Development

Other (describe): _____

Top of lap pipe or reduction in casing: _____ feet. If telescoped or more than one screen, describe on back of page

Logs run (circle all applicable): No log run Electric Gamma Ray Density Sonic Neutron Other: _____

Name of organization running log(s): _____

I certify that the well was drilled, constructed, and completed in accordance with all applicable requirements of the Mississippi Department of Environmental Quality and/or the Mississippi Department of Health regulations and state laws.

Michael S. Havard 0-673
Print Name of Water Well Contractor and License No.

[Signature]
Signature of Water Well Contractor

RECEIVED
MAY 12 2005
BY: OLWR

If well telescopes please sketch below and show depths.


L-128

Ground Level _____

Description of Formations Encountered	From	To
Clay	0	12
Clay	12	18
Sand (med)	18	48

If more than one screen, show location of each on sketch

Sketch the property layout and include the following: 1) the well location; 2) any permanent structures on the property that may aid in locating the well; 3) any roads, power lines, or other items that may aid in locating the property and the well; 4) indicate direction.

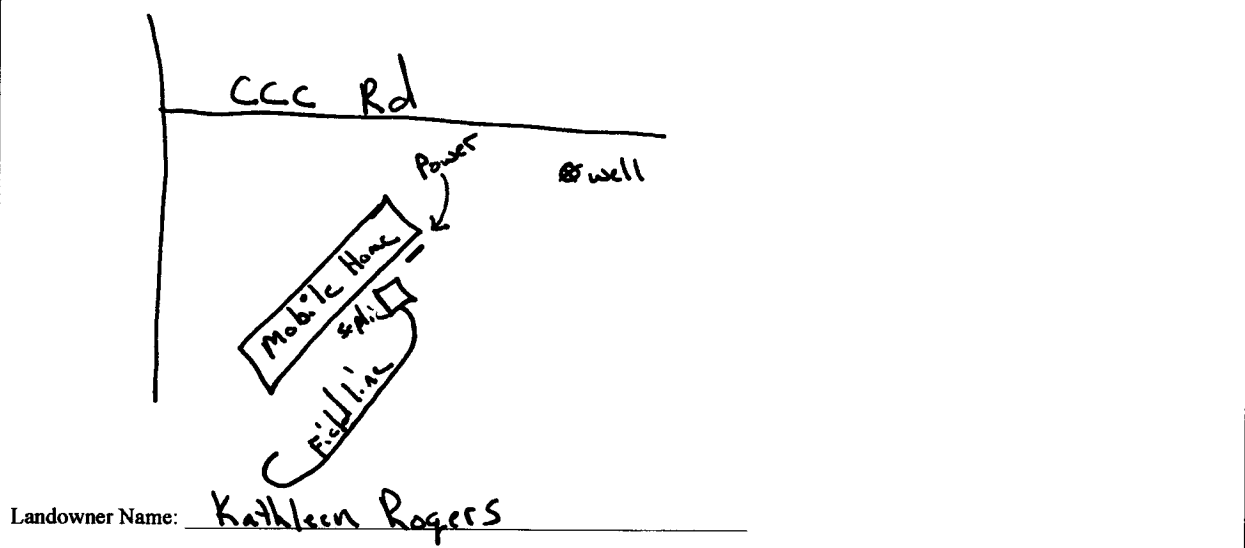



Signature of Water Well Contractor

RECEIVED
MAY 12 2005
BY: OLWR

STATE WELL REPORT

Part 2

Pump Installer's Completion Report
 Mississippi Department of Environmental Quality
 Office of Land and Water Resources
 P.O. Box 10631
 Jackson, MS 39289-0631
 (601)961-5210
 (601)354-6938 (fax)

County: George
 Permit #:
 Driller: Michael S. Havard
 Date completed: 04-15-05

For Office Use Only:

Aquifer:
 Well #: L-128
 Elevation:

This report should be prepared by the pump installer in detail and filed with the Department within 30 days of the installation of pump.

Well Owner Information	Well Location
Owner Name: <u>Kathleen Rogers</u>	Latitude: <u>N30°48.946</u> Longitude: <u>W88°55.831</u>
Mailing Address: <u>135 Donato Drive</u>	Method of Lat/Long (circle one): <input type="radio"/> Conventional Survey,
<u>Lucedale MS 39452</u>	USGS quad, Hand-held GPS, Survey-grade GPS
City State Zip Code	¼ Sec <u>5</u> Twn <u>T35</u> Rng <u>R6W</u>
Telephone No. (<u>601</u>) <u>766-0053</u>	Distance Direction Nearest Town
	<u>8</u> Miles <u>S</u> of <u>Lucedale</u>

Pump Type Circle one	Power Type Circle one
Air Lift <input type="radio"/> <u>Jet</u> <input type="radio"/> Submersible	Diesel Engine Gasoline Engine Natural Gas
Bucket <input type="radio"/> Piston <input type="radio"/> Turbine	<u>Electric Motor</u> <input type="radio"/> Hand <input type="radio"/> Tractor PTO
Centrifugal <input type="radio"/> Rotary <input type="radio"/> Flowing Well	Windmill Other (specify): _____
Other (specify): _____	Horse Power Rating of Motor: <u>1</u>
Date Pump Installed: <u>04-15-05</u>	Setting Depth: <u>40</u> feet
Rated Pump Capacity: <u>8-10</u> Gallons Per Minute	Number of Stages: <u>2</u>

Pump Test Data	Method of Measuring Water Level Circle one
Date Well Tested: <u>04-15-05</u>	<u>Air Line</u> <input type="radio"/> Electric Measuring Line <input type="radio"/> Steel Tape <input type="radio"/>
Static Water Level (A): <u>21</u> Feet Below Land Surface	Other (specify): _____
Pumping Water Level (B): <u>38</u> Feet Below Land Surface	For flowing well, measured shut in head: _____ feet
Drawdown [(B) - (A)]: <u>17</u> Feet Below Land Surface	Well yielded <u>12</u> GPM with a drawdown of
Test Pumping Rate: <u>12</u> Gallons Per Minute	<u>17</u> feet after <u>5</u> hours of pumping
Duration of Pump Test (minimum 4 hours): <u>5</u> hours	

I HEREBY CERTIFY that the above statements are true to the best of my knowledge.

Michael Stephen Havard [Signature]
 Print Name of Pump Installer and License No. (if applicable) Signature of Pump Installer

RECEIVED
 MAY 12 2005
 BY: OLWR