

State Well Report

Part 1

Mississippi Department of Environmental Quality
Office of Land and Water Resources
P.O. Box 10631
Jackson, MS 39289-0631
(601)961-5210
(601)354-6938 (fax)

County: George
Permit #: _____
Driller: Michael S. Harvard
Date drilling completed: 03-07-07

For Office Use Only:
Aquifer: _____
Well #: L-155
L. S. Elevation: _____
E-log #: _____

State Law requires that this report be prepared by the driller in detail and filed with the Department within 30 days of completion of drilling of the well.

Well Owner Information	Well Location
Owner Name <u>Eric Barthol</u>	Latitude: <u>30° 48' 96" 25</u> Longitude: <u>88° 35' 41" 25</u>
Mailing Address: <u>177 CCC Rd</u>	Method of Lat/Long (circle one): <u>58</u> Conventional Survey, USGS quad, <u>Hand-held GPS</u> Survey-grade GPS
<u>Lucedale MS 39452</u> City State Zip Code	<u>SW</u> 1/4 <u>NW</u> 1/4 Sec <u>4</u> Twn <u>T3S</u> Rng <u>RGW</u> <u>SE</u>
Telephone No. (<u>601</u>) <u>508-3593</u>	Distance <u>5</u> Miles Direction <u>S</u> of Nearest Town <u>Lucedale</u>

Well Data

Purpose of Well (circle one) Home Industrial Public Supply Irrigation Fish Culture Other: _____

Date well drilling started: 03-07-07 Date well drilling completed: 03-07-07

If flowing, method of flow regulation: Valve _____ Other (describe) _____

Static Water Level: 34 feet above or below (circle one) land surface Date measured: 03-08-07

Method of Measurement (circle one) steel tape electric tape air line other: _____

Hole depth: 98 Well depth: 98 Well grouted to a depth of 15 feet

Type of grout (circle one): Cement Bentonite Mix

Casing length: 88 feet Casing diameter: 4 inches Type of casing: PVC 540 BE

Screen length: 10 feet Screen diameter: 4 inches Type of screen: WOP 540

Screen slot size: .006 inches Setting depth: From 88 feet to 98 feet

Type of completion (circle all applicable): Gravel packed Underreamed Telescoped Open hole Natural Development

Other (describe): _____

Top of lap pipe or reduction in casing: _____ feet. If telescoped or more than one screen, describe on back of page

Logs run (circle all applicable): No log run Electric Gamma Ray Density Sonic Neutron Other: _____

Name of organization running log(s): _____

I certify that the well was drilled, constructed, and completed in accordance with all applicable requirements of the Mississippi Department of Environmental Quality and/or the Mississippi Department of Health regulations and state laws.

Michael S. Harvard 0-693
Print Name of Water Well Contractor and License No.

[Signature]
Signature of Water Well Contractor

RECEIVED
MAR 21 2007
BY: OLWR


If well telescopes please sketch below and show depths.

Ground Level

Description of Formations Encountered	From	To
Topsand	0	4
Clay	4	38
silt	38	48
Sand	48	62
Clay	62	65
Sand (med)	65	72
Sand (med)	72	98

If more than one screen, show location of each on sketch

Sketch the property layout and include the following: 1) the well location; 2) any permanent structures on the property that may aid in locating the well; 3) any roads, power lines, or other items that may aid in locating the property and the well; 4) indicate direction.

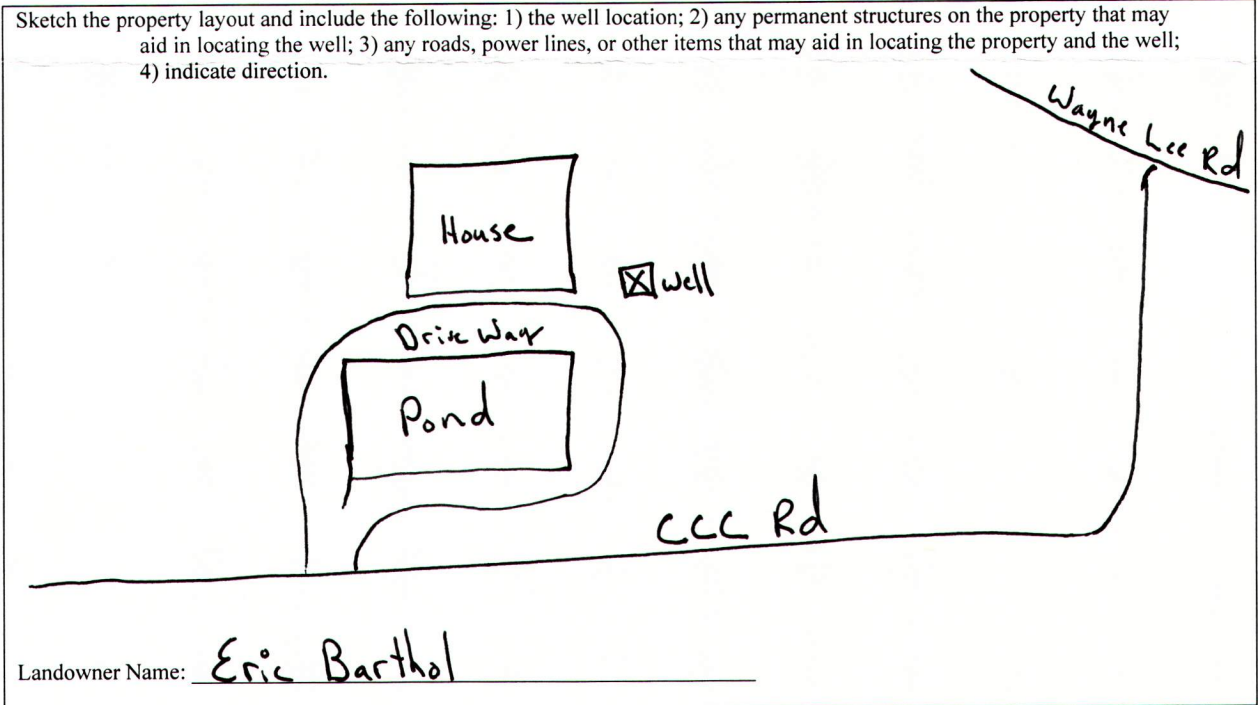

Landowner Name: Eric Barthol



 Signature of Water Well Contractor

RECEIVED
MAR 21 2007
BY: OLWR

STATE WELL REPORT

Part 2

Pump Installer's Completion Report
 Mississippi Department of Environmental Quality
 Office of Land and Water Resources
 P.O. Box 10631
 Jackson, MS 39289-0631
 (601)961-5210
 (601)354-6938 (fax)

County: George
 Permit #: _____
 Driller: Michael S. Harvard
 Date completed: _____

For Office Use Only:

Aquifer: _____
 Well #: L-155
 Elevation: _____

This report should be prepared by the pump installer in detail and filed with the Department within 30 days of the installation of pump.

Well Owner Information	Well Location
Owner Name: <u>Eric Barthol</u>	Latitude: <u>N30°48.96</u> Longitude: <u>W88°35.41</u>
Mailing Address: <u>177 CCC Rd</u>	Method of Lat/Long (circle one): Conventional Survey, USGS quad, <u>Hand-held GPS</u> Survey-grade GPS
<u>Lucedale MS 39452</u> City State Zip Code	¼ ¼ Sec <u>4</u> Twn <u>T35</u> Rng <u>R4W</u>
Telephone No. (<u>601</u>) <u>508-3593</u>	Distance Direction Nearest Town <u>5</u> Miles <u>S</u> of <u>Lucedale</u>

Pump Type Circle one	Power Type Circle one
Air Lift Jet <u>Submersible</u>	Diesel Engine Gasoline Engine Natural Gas
Bucket Piston Turbine	<u>Electric Motor</u> Hand Tractor PTO
Centrifugal Rotary Flowing Well	Windmill Other (specify): _____
Other (specify): _____	Horse Power Rating of Motor: _____
Date Pump Installed: <u>3-08-07</u>	Setting Depth: <u>93</u> feet
Rated Pump Capacity: _____ Gallons Per Minute	Number of Stages: <u>9</u>

Pump Test Data	Method of Measuring Water Level Circle one
Date Well Tested: <u>3-08-07</u>	Air Line Electric Measuring Line <u>Steel Tape</u>
Static Water Level (A): <u>34</u> Feet Below Land Surface	Other (specify): _____
Pumping Water Level (B): <u>55</u> Feet Below Land Surface	For flowing well, measured shut in head: _____ feet
Drawdown [(B) - (A)]: <u>21</u> Feet Below Land Surface	Well yielded <u>35</u> GPM with a drawdown of <u>21</u> feet after <u>4.5</u> hours of pumping
Test Pumping Rate: <u>35</u> Gallons Per Minute	
Duration of Pump Test (minimum 4 hours): <u>4.5</u> hours	

I HEREBY CERTIFY that the above statements are true to the best of my knowledge.

Michael S. Harvard 0-693 _____
 Print Name of Pump Installer and License No. (if applicable) Signature of Pump Installer

RECEIVED
 MAR 21 2007
 BY: OLWR